

**MISSISSIPPI DEPARTMENT OF NATURAL RESOURCES**  
 Bureau of Land and Water Resources  
 Southport Mall  
 P.O. Box 10631  
 Jackson, Mississippi 39209  
**WATER WELL DRILLERS LOG**

LINCOLN  
L33  
4-8-85

April 8 19 85 Gretn Water Well Lincoln  
 date well completed firm name county well located

**LANDOWNER:** Jim Sutton  
Rt. 1, Box 460  
Brookhaven  
 (mailing address)

description of formations encountered	from	to
clay	1	20
sand	20	80
white clay	80	100
blue clay	100	120
whiteclay	120	130
sand	120	218

**WELL LOCATION:**  
 sec. 7 T. 6 (N) R. 7 (E)  
 (distance) miles SW of Brookhaven  
 (direction) (nearest town)

**WELL PURPOSE:** home  
 (home, irrigation, municipal, industrial)

**WELL COMPLETION DATA:**

- (1) diameter (inches) 4
- (2) total depth (feet) 218
- (3) static water level (feet) 96 below above top of ground.
- (4) casing PVC 208  
 (material) (depth)  
4"  
 (size) If telescope see back.
- (5) screen 10' 208'  
 (length) (depth to top)  
4" PVC  
 (size) (material)
- (6) pump did not install  
 (HP) (yield gpm)  
 (type power)
- (7) electric log no  
 (yes or no)  
 (organization running log)
- (8) how well bottom plugged  
back wash valve

**RECEIVED**


MAY 17 1985

Department of Natural Resources  
 Bureau of Land & Water Resources

**DRILLERS REMARKS:**

If well telescopes please sketch and show depths.

GROUND LEVEL

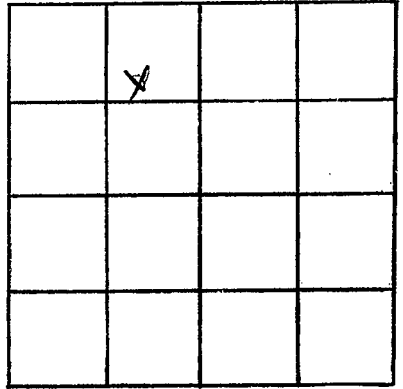

SECTION 7

Please indicate well location X.

ADDITIONAL INFORMATION

If more than one screen,  
show locations of each on sketch.