

L34  
 LINCOLN  
 7-25-85

MISSISSIPPI  
 BOARD OF WATER COMMISSIONERS  
 416 North State Street  
 Jackson, Mississippi 39201

CODED

WATER WELL DRILLERS LOG

7-25-85 Griner Drilling Service, Inc. Lincoln  
 date well completed firm name county well located

LANDOWNER:  
 Marion Drilling  
 P.O. Box 3027  
 One Marion Avenue  
 Mobile, Ala. 36652  
 (mailing address)

description of formations encountered	from	to
SAND	0	50
Clay	50	85
SAND, p. gravel	85	214
SAND stone	214	215

WELL LOCATION: 400' S + 1350' E  
 No. 1 sec. 2 T 6 N R 7 E of Union  
 Ziegler Brookhaven  
 (distance) (direction) (nearest town)

WELL PURPOSE: oilfield supply  
 (home, irrigation, municipal, industrial)

WELL COMPLETION DATA:

- (1) diameter (inches) 3"
- (2) total depth (feet) 215'
- (3) static water level (feet) 50 below top of ground.
- (4) casing 210' steel (material) (depth)  
 3" If telescope see back. (size)
- (5) screen 42' 168' (length) (depth to top)  
 3" perforated (size) (material)
- (6) pump 80 (HP) (yield gpm)  
 AC (type power)
- (7) electric log (yes or no)

CODED

(organization running log)

(8) how well bottom plugged orange peel


DRILLERS REMARKS:

RECEIVED  
 SEP 28 1985

Department of Natural Resources  
 Bureau of Land & Water Resources

If well telescopes please sketch and show depths.

GROUND LEVEL

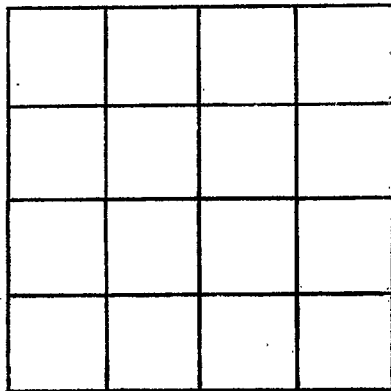

SECTION \_\_\_\_\_

Please indicate well location X.

ADDITIONAL INFORMATION

If more than one screen,  
show locations of each on sketch.