

L35
 LINCOLN
 9-11-85

MISSISSIPPI
 BOARD OF WATER COMMISSIONERS
 416 North State Street
 Jackson, Mississippi 39201

CODED

WATER WELL DRILLERS LOG

Griner Drilling
 Service, Inc.

Lincoln

date well completed

firm name

county well located

LANDOWNER:

See Land Drilling Co.
 900 Dunn Street
 Houma, La. 70360
 (mailing address)

description of formations encountered

from

to

WELL LOCATION: 674'N+349'W of
 sec 23 T 6 N R 7 E SE 1/4

Amerada Hess Corp. Boque Chitto
 NO. 2 (distance) miles (direction) of (nearest town)
 T. Brady et al 23-16

WELL PURPOSE: oilfield supply
 (home, irrigation, municipal, industrial)

WELL COMPLETION DATA:

- (1) diameter (inches) 3"
- (2) total depth (feet) 255'
- (3) static water level (feet) 76' ^{below} _{above} top of ground.
- (4) casing steel 252' (material) (depth)
 3" (size) If telescope see back.
- (5) screen 42' 210' (length) (depth to top)
 3" perforated (size) (material)
- (6) pump — 75 (HP) (yield gpm)
 AC (type power)
- (7) electric log (yes or no)

(organization running log)

(8) how well bottom plugged orange
 peel

DRILLERS REMARKS:


CODED

RECEIVED
 SEP 28 1985

Department of Natural Resources
 Bureau of Land & Water

If well telescopes please
sketch and show depths.

GROUND LEVEL

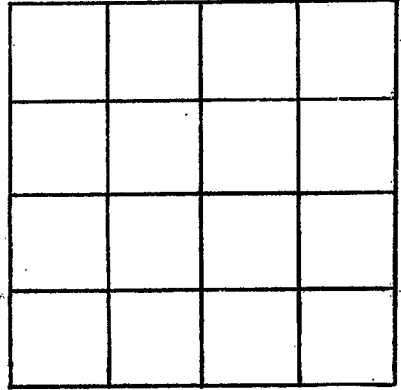

SECTION _____

Please indicate well location X.

ADDITIONAL INFORMATION

If more than one screen,
show locations of each on sketch.