

**MISSISSIPPI DEPARTMENT OF ENVIRONMENTAL QUALITY**

Office of Land and Water Resources

P. O. Box 10631  
Jackson, MS 39289-0631  
**WATER WELL DRILLERS LOG**

COUNTY WELL LOCATED <b>Lincoln</b>	
WELL NUMBER <b>L-58</b>	CODED
DATE WELL COMPLETED <b>7/15/04</b>	

PERMIT NUMBER
NAME OF DRILLING FIRM <b>Green Water Well &amp; Supply, Inc.</b>

NAME & MAILING ADDRESS OF LANDOWNER <b>Marie Laird</b>			
<b>1203 George Tr., Brookhaven</b>			
Latitude:			
Longitude:			
WELL LOCATION	SEC <b>6</b>	TOWNSHIP <b>6</b>	RANGE <b>7</b>
DISTANCE <b>7</b> Miles		DIRECTION <b>SW</b>	NEAREST TOWN <b>of Brookhaven</b>
OTHER LANDMARK			
WELL PURPOSE: <input checked="" type="checkbox"/> Home Irrigation, <input type="checkbox"/> Municipal, <input type="checkbox"/> Industrial, <input type="checkbox"/> Fish Pond, etc.			

<b>PUMP DATA</b>			
PUMP TYPE (Circle One):			
<input checked="" type="checkbox"/> Submersible	<input type="checkbox"/> Turbine	<input type="checkbox"/> Jet	<input type="checkbox"/> Flowing Well
Other (Describe) _____			
POWER TYPE (Circle One):			
<input checked="" type="checkbox"/> Electric	<input type="checkbox"/> Tractor	<input type="checkbox"/> Diesel	<input type="checkbox"/> Gasoline
<input type="checkbox"/> Butane	Other (Describe) _____		
H/P <b>.5</b>			

DESCRIPTION OF FORMATIONS ENCOUNTERED	FROM	TO
<b>red clay</b>	<b>0</b>	<b>47</b>
<b>sand &amp; gravel</b>	<b>47</b>	<b>78</b>
<b>white clay</b>	<b>78</b>	<b>83</b>
<b>RECEIVED</b>		
<b>AUG 04 2004</b>		
<b>BY: OILWIR</b>		
Top of Lap Pipe or Reduction in Casing		
FEET	IF TELESCOPED OR MORE THAN ONE SCREEN: USE BACK PAGE	

<b>WELL DATA</b>		
Well Depth <b>80</b>	Casing Diameter (in.) <b>4</b>	Casing Length (ft.) <b>60</b>
Type of Casing <b>PVC</b>	Hole Depth <b>84</b>	Depth to Static Water Level <b>56</b>
TYPE OF COMPLETION: (Circle One or More):		
<input checked="" type="checkbox"/> Gravel Packed	<input type="checkbox"/> Underreamed	<input type="checkbox"/> Telescoped
<input type="checkbox"/> Natural Development	<input type="checkbox"/> Open Hole	<input type="checkbox"/> Other
(Describe) _____		
WELL GROUTED TO A DEPTH OF <b>10</b> FEET		
Type Grout (circle one): Cement, <input checked="" type="checkbox"/> Bentonite, or Mix		

<b>SCREEN DATA</b>		
Diameter - Inches <b>4</b>	Length - Feet <b>20</b>	Slot Size - Inches <b>.010</b>
Screen Type <b>PVC</b>	Depth to Bottom - Feet <b>80</b>	

I certify that the well was drilled, constructed and completed in accordance with all applicable Requirements of the Mississippi Department of Environmental Quality and/or the Mississippi Department of Health regulations and state laws.


**Brian McCloud** <sup>664</sup>  
Signature of Licensed Driller and License No. **664**

7/15/04  
Date

Additional Information Required On Back

If well telescopes please sketch and show depths.

GROUND LEVEL

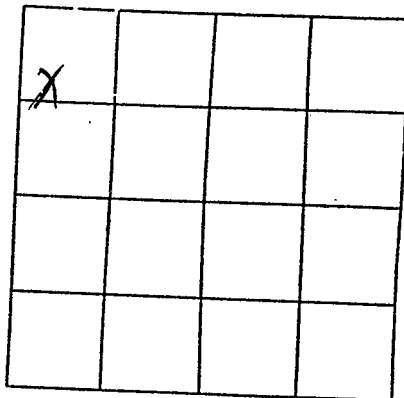

SECTION 6

Please indicate well location X.

Pump Capacity (GPM)	No. of Stages	Setting Depth	
<u>10</u>	<u>9</u>	<u>79</u>	FT.
PUMP TEST			
Well yielded <u>11</u> GPM with			
a drawdown of <u>11</u> ft.			
after <u>1</u> hours of pumping			

LOG DATA

TYPE OF LOG RUN (Circle One): No Log Run  
 Electric, Gamma Ray, Density, Sonic, Neutron,  
 Other (Describe) \_\_\_\_\_

Name of Organization Running Log \_\_\_\_\_

GEOLOGIC DATA (Office Use Only)

Surface Elev.	Geologic Unit	Unit Thickness	Depth to Top
Subs. SWL	Date	Analysis	Aquifer Test

Driller's Remarks

If more than one screen, show location of each on sketch.