

State Well Report

Part 1

Mississippi Department of Environmental Quality
Office of Land and Water Resources
P.O. Box 10631
Jackson, MS 39289-0631
(601)961-5210
(601)354-6938 (fax)

For Office Use Only:

Aquifer: L114
Well #: _____
L. S. Elevation: _____
E-log #: _____

County: Lincoln
Permit #: _____
Driller: GRENN WATER WELL &
SUPPLY, INC
Date drilling completed: 7/30/10

State Law requires that this report be prepared by the driller in detail and filed with the Department within 30 days of completion of drilling of the well.

Well Owner Information	Well Location
Owner Name: <u>Loyd Case</u>	Latitude: <u>31° 30' 24.4"</u> Longitude: <u>70° 29' 64.0"</u>
Mailing Address: <u>171 Jaci Dr</u>	Method of Lat/Long (circle one): <u>Conventional Survey</u>
<u>Brookhaven MS 39601</u>	USGS quad, <u>Hand-held GPS</u> Survey-grade GPS
City: _____ State: _____ Zip Code: _____	<u>SE</u> 1/4 <u>NW</u> 1/4 Sec <u>10</u> Twn <u>6N</u> Rng <u>7E</u>
Telephone No. <u>(601) 835-6167</u>	Distance: <u>2</u> Miles Direction: <u>SW</u> of Nearest Town: <u>Brookhaven</u>

Well Data

Purpose of Well (circle one) Home Industrial Public Supply Irrigation Fish Culture Other: Shop

Date well drilling started: 7/30/10 Date well drilling completed: 7/30/10

If flowing, method of flow regulation: Valve _____ Other (describe) _____

Static Water Level: 41 feet above or below (circle one) land surface Date measured: 7/30/10

Method of Measurement (circle one) steel tape electric tape air line other: _____

Hole depth: 102 Well depth: 98 Well grouted to a depth of 10 feet

Type of grout (circle one): Cement Bentonite Mix

Casing length: 88 feet Casing diameter: 4 inches Type of casing: PVC

Screen length: 10 feet Screen diameter: 4 inches Type of screen: PVC

Screen slot size: .010 inches Setting depth: From 88 feet to 98 feet

Type of completion (circle all applicable): Gravel packed Underreamed Telescoped Open hole Natural Development

Other (describe): _____

Top of lap pipe or reduction in casing: _____ feet. If telescoped or more than one screen, describe on back of page

Logs run (circle all applicable): No log run Electric Gamma Ray Density Sonic Neutron Other: _____

Name of organization running log(s): _____

I certify that the well was drilled, constructed, and completed in accordance with all applicable requirements of the Mississippi

Department of Environmental Quality and/or the Mississippi Department of Health regulations and state laws.

GRENN WATER WELL & SUPPLY, INC.
WILLIAM L. HARDIN, LIC. NO. 0-802

Print Name of Water Well Contractor and License No.

Signature of Water Well Contractor

Clay Hardin

RECEIVED

AUG 10 2010

BY: OLWR

If well telescopes please sketch below and show depths.


Ground Level

--

Description of Formations Encountered	From	To
Red Citronelle Clay	0	11
Red Sand (Fine)	11	32.5
Red Clay	35	42
Coarse sand & Gravel	42	98
Yellow Clay	98	102

If more than one screen, show location of each on sketch

Sketch the property layout and include the following: 1) the well location; 2) any permanent structures on the property that may aid in locating the well; 3) any roads, power lines, or other items that may aid in locating the property and the well; 4) indicate direction.

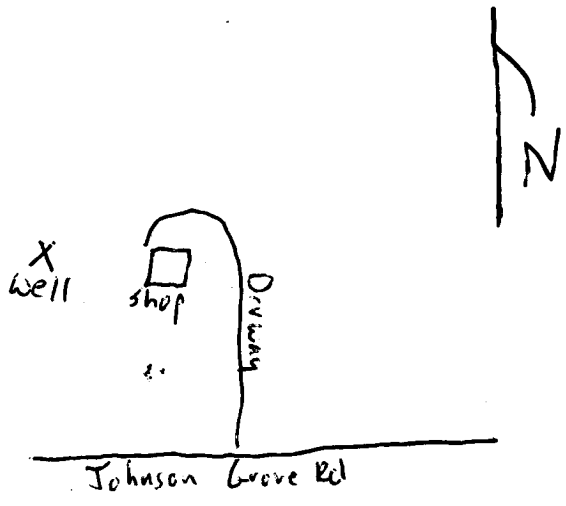

Landowner Name: Loyd Case

GRENN WATER WELL & SUPPLY, INC.
WILLIAM L. HARDIN, LIC. NO. 0-802

Chaz Hardin
Signature of Water Well Contractor

STATE WELL REPORT

Part 2

Pump Installer's Completion Report
 Mississippi Department of Environmental Quality
 Office of Land and Water Resources
 P.O. Box 10631
 Jackson, MS 39289-0631
 (601)961-5210
 (601)354-6938 (fax)

County: Lincoln
 Permit #: _____
 Driller: GRENN WATER WELL & SUPPLY, INC.
 Date completed: 7/30/10

For Office Use Only:

Aquifer: 2114
 Well #: _____
 Elevation: _____

This report should be prepared by the pump installer in detail and filed with the Department within 30 days of the installation of pump.

Well Owner Information	Well Location
Owner Name: <u>Loyd Case</u>	Latitude: <u>31°30'244" N</u> Longitude: <u>90°29'640" W</u>
Mailing Address: <u>171 Jaci Dr</u>	Method of Lat/Long (circle one): Conventional Survey, USGS quad, <u>Hand-held GPS</u> Survey-grade GPS
<u>Brookhaven MS 39601</u> City State Zip Code	<u>SE 1/4 NW 1/4 Sec 10 Twn 6N Rng 7E</u>
Telephone No. <u>(601) 835 6167</u>	Distance Direction Nearest Town <u>2</u> Miles <u>SW</u> of <u>Brookhav</u>

Pump Type Circle one	Power Type Circle one
Air Lift Jet <u>Submersible</u>	Diesel Engine Gasoline Engine Natural Gas
Bucket Piston Turbine	<u>Electric Motor</u> Hand Tractor PTO
Centrifugal Rotary Flowing Well	Windmill Other (specify): _____
Other (specify): _____	Horse Power Rating of Motor: <u>1/2</u>
Date Pump Installed: <u>7/30/10</u>	Setting Depth: <u>96</u> feet
Rated Pump Capacity: <u>10</u> Gallons Per Minute	Number of Stages: <u>9</u>

Pump Test Data	Method of Measuring Water Level Circle one
Date Well Tested: <u>7/30/10</u>	Air Line <u>Electric Measuring Line</u> Steel Tape
Static Water Level (A): <u>41</u> Feet Below Land Surface	Other (specify): _____
Pumping Water Level (B): <u>80</u> Feet Below Land Surface	For flowing well, measured shut in head: _____ feet
Drawdown [(B) - (A)]: <u>39</u> Feet Below Land Surface	Well yielded <u>8</u> GPM with a drawdown of
Test Pumping Rate: <u>11</u> Gallons Per Minute	<u>30</u> feet after <u>4</u> hours of pumping
Duration of Pump Test (minimum 4 hours): <u>4</u> hours	

I HEREBY CERTIFY that the above statements are true to the best of my knowledge.
 GRENN WATER WELL & SUPPLY, INC.
WILLIAM L. HARDIN, LIC. NO. 0-802
 Print Name of Pump Installer and License No. (if applicable)

Chaz Hardin
 Signature of Pump Installer

RECEIVED
 AUG 14 2010
 BY: OJWP