

# State Well Report

## Part 1

Mississippi Department of Environmental Quality  
Office of Land and Water Resources  
P.O. Box 10631  
Jackson, MS 39289-0631  
(601)961-5210  
(601)354-6938 (fax)

For Office Use Only:

Aquifer: \_\_\_\_\_  
Well #: K-67  
L. S. Elevation: L134  
E-log #: \_\_\_\_\_

County: Lincoln  
Permit #: \_\_\_\_\_  
Driller: Brian McLendon  
Date drilling completed: 9/1/04

State Law requires that this report be prepared by the driller in detail and filed with the Department within 30 days of completion of drilling of the well.

Well Owner Information	Well Location
Owner Name: <u>Ray Herrington</u>	Latitude: <u>31° 29:46"</u> Longitude: <u>90° 32:31"</u>
Mailing Address: <u>0802 Power Meadow Dr.</u>	Method of Lat/Long (circle one): <u>Conventional Survey</u>
<u>Boque Chitto MS 39629</u>	USGS quad, Hand-held GPS, Survey-grade GPS
City State Zip Code	<u>NE 1/4 SW 1/4</u> Sec <u>18</u> Twn <u>6N</u> Rng <u>6E</u>
Telephone No. <u>(601) 835-7944</u>	Distance <u>6</u> Miles Direction <u>SW</u> of Nearest Town <u>Brookhaven</u>

Well Data

Purpose of Well (circle one) Home Industrial Public Supply Irrigation Fish Culture Other: \_\_\_\_\_

Date well drilling started: 8/31/04 Date well drilling completed: 8/31/04

If flowing, method of flow regulation: Valve \_\_\_\_\_ Other (describe) \_\_\_\_\_

Static Water Level: 84 feet above or below (circle one) land surface Date measured: 8/31/04

Method of Measurement (circle one) steel tape electric tape air line other: \_\_\_\_\_

Hole depth: 214 Well depth: 210 Well grouted to a depth of 10 feet

Type of grout (circle one): Cement Bentonite Mix

Casing length: 200 feet Casing diameter: 4 inches Type of casing: PVC

Screen length: 10 feet Screen diameter: 4 inches Type of screen: PVC

Screen slot size: 10/10 inches Setting depth: From 200 feet to 210 feet

Type of completion (circle all applicable): Gravel packed Underreamed Telescoped Open hole Natural Development

Other (describe): \_\_\_\_\_

Top of lap pipe or reduction in casing: \_\_\_\_\_ feet. If telescoped or more than one screen, describe on back of page

Logs run (circle all applicable): No log run Electric Gamma Ray Density Sonic Neutron Other: \_\_\_\_\_

Name of organization running log(s): \_\_\_\_\_

I certify that the well was drilled, constructed, and completed in accordance with all applicable requirements of the Mississippi

Department of Environmental Quality and/or the Mississippi Department of Health regulations and state laws.

Green Water Well + Supply  
Brian McLendon #664

Brian McLendon  
Signature of Water Well Contractor

Print Name of Water Well Contractor and License No.

RECEIVED

SEP 07 2004

BY: OLWR

If well telescopes please sketch below and show depths.

K-6T L134

Ground Level


Description of Formations Encountered

From To


red clay	0	20
sand & gravel	20	60
white clay	60	75
blue clay	75	145
white clay	145	160
sand	160	213
red clay	213	214

If more than one screen, show location of each on sketch

Sketch the property layout and include the following: 1) the well location; 2) any permanent structures on the property that may aid in locating the well; 3) any roads, power lines, or other items that may aid in locating the property and the well; 4) indicate direction.

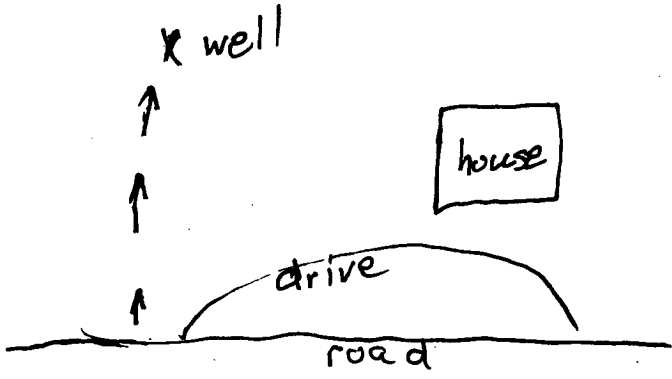

Landowner Name: Ray Herrington

Bruce McClendon  
Signature of Water Well Contractor

RECEIVED  
SEP 07 2004  
BY: OLWR

# STATE WELL REPORT

## Part 2

**Pump Installer's Completion Report**  
 Mississippi Department of Environmental Quality  
 Office of Land and Water Resources  
 P.O. Box 10631  
 Jackson, MS 39289-0631  
 (601)961-5210  
 (601)354-6938 (fax)

County: Lincoln  
 Permit #: \_\_\_\_\_  
 Driller: Brian McClendon  
 Date completed: 9/1/04

For Office Use Only:

Aquifer: L134  
 Well #: K-61  
 Elevation: \_\_\_\_\_

This report should be prepared by the pump installer in detail and filed with the Department within 30 days of the installation of pump.

Well Owner Information	Well Location
Owner Name: <u>Ray Herrington</u>	Latitude: <u>N 31° 29.767</u> Longitude: <u>W 90° 32.347</u>
Mailing Address: <u>0802 Lower Meadville Dr</u>	Method of Lat/Long (circle one): Conventional Survey,
<u>Boque</u> <u>Chittoms</u> <u>39629</u>	USGS quad, <u>Hand-held GPS</u> Survey-grade GPS
City State Zip Code	<u>NE 1/4 SW 1/4</u> Sec <u>18</u> Twn <u>6N</u> Rng <u>6E</u>
Telephone No. <u>(601) 835-7944</u>	Distance Direction <u>7</u> Nearest Town <u>7E</u>
	<u>6</u> Miles <u>SW</u> of <u>Brookhaven</u>

Pump Type Circle one	Power Type Circle one
Air Lift Jet <input checked="" type="radio"/> <u>Submersible</u>	Diesel Engine Gasoline Engine Natural Gas
Bucket Piston Turbine	<input checked="" type="radio"/> <u>Electric Motor</u> Hand Tractor PTO
Centrifugal Rotary Flowing Well	Windmill Other (specify): _____
Other (specify): _____	Horse Power Rating of Motor: <u>3/4</u>
Date Pump Installed: <u>9/1/04</u>	Setting Depth: <u>120</u> feet
Rated Pump Capacity: <u>10</u> Gallons Per Minute	Number of Stages: <u>12</u>

Pump Test Data	Method of Measuring Water Level Circle one
Date Well Tested: <u>9/1/04</u>	Air Line <input checked="" type="radio"/> <u>Electric Measuring Line</u> Steel Tape
Static Water Level (A): <u>84</u> Feet Below Land Surface	Other (specify): _____
Pumping Water Level (B): <u>90</u> Feet Below Land Surface	For flowing well, measured shut in head: _____ feet
Drawdown [(B) - (A)]: <u>6</u> Feet Below Land Surface	Well yielded <u>13</u> GPM with a drawdown of
Test Pumping Rate: <u>13</u> Gallons Per Minute	<u>6</u> feet after <u>4</u> hours of pumping
Duration of Pump Test (minimum 4 hours): <u>4</u> hours	

I HEREBY CERTIFY that the above statements are true to the best of my knowledge.

Brian McClendon 664 Brian McClendon  
 Print Name of Pump Installer and License No. (if applicable) Signature of Pump Installer

RECEIVED

SEP 07 2004  
 BY: OLWR