

Lincoln
L 2000
10-29-75

MISSISSIPPI
BOARD OF WATER COMMISSIONERS
416 North State Street
Jackson, Mississippi 39201

WATER WELL DRILLERS LOG

Oct 29 1975 Grenn Water Well Contr. Lincoln
date well completed firm name county well located


LANDOWNER:	description of formations encountered	from	to
A. H. Bass Rt. 4	Citronelle	0	67
Bogue Chitto, Miss. (mailing address)			
WELL LOCATION: sec. 5 T. 6 N R. 7 E 134 3 miles SW of Brookhaven (distance) (direction) (nearest town)			
WELL PURPOSE: home (home, irrigation, municipal, industrial)			
WELL COMPLETION DATA:			
(1) diameter (inches) 6			
(2) total depth (feet) 67			
(3) static water level (feet) 32 below top of ground			
(4) casing PVC 61 (material) (depth) 4" (size) if telescope see back.			
(5) screen 6' 61' (length) (depth to top) .010 PVC (size) (material)			
(6) pump did not install (HP) (yield gpm)			
(type power)			
(7) electric log no (yes or no)			
(organization running log)			
(8) how well bottom plugged wood			
DRILLERS REMARKS:			

REGISTERED
MAY 7 1975

MISS. BOARD OF WATER COMMISSIONERS

If well telescopes please sketch and show depths.

GROUND LEVEL

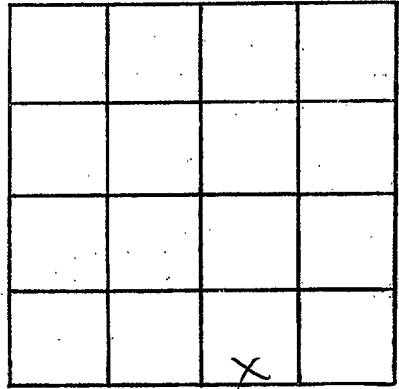

SECTION 5

Please indicate well location X.

ADDITIONAL INFORMATION

If more than one screen, show locations of each on sketch.