

Lincoln
 L 2001
 5/3/76

MISSISSIPPI
 BOARD OF WATER COMMISSIONERS
 416 North State Street
 136 Jackson, Mississippi 39201

WATER WELL DRILLERS LOG

May 3 1976 Rever Well Ser Lincoln
 date well completed firm name county well located

LANDOWNER:
Mr. Harry Smith
Rt. Brookhaven
 (mailing address)

description of formations encountered	from	to
<u>Red Clay</u>	<u>0</u>	<u>18</u>
<u>Red sand</u>	<u>18</u>	<u>84</u>
<u>pea gravel bed</u>	<u>84</u>	<u>92</u>

WELL LOCATION:
 sec. 3 T. 6 N R. 7 E
3 1/2 miles S.W. of Brookhaven
 (distance) (direction) (nearest town)

WELL PURPOSE: Trailer
 (home, irrigation, municipal, industrial)

WELL COMPLETION DATA:

(1) diameter (inches) 4"

(2) total depth (feet) 92

(3) static water level (feet) 68, below top of ground.

(4) casing plastic bottom
 (material) (depth)

✓ if telescope see back.
 (size)

(5) screen 6', 86
 (length) (depth to top)

4", plastic
 (size) (material)

(6) pump 1/2 Sub, 10
 (HP) (yield gpm)

slut
 (type power)

(7) electric log no
 (yes or no)

(organization running log)

(8) how well bottom plugged
wood plug


DRILLERS REMARKS:
no remarks

RECEIVED
 AUG 16 1976

MISS. Bd. of Water Comm.

If well telescopes please sketch and show depths.

GROUND LEVEL

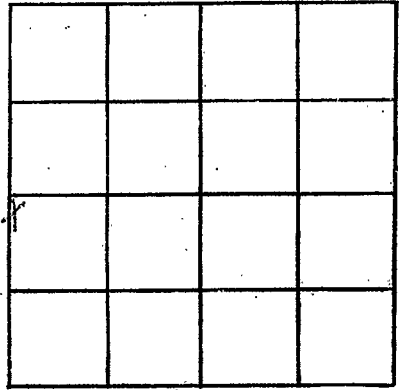

SECTION 3

Please indicate well location X.

ADDITIONAL INFORMATION

If more than one screen, show locations of each on sketch.