

Lincoln  
 L 7008  
 6-7-76

MISSISSIPPI  
 BOARD OF WATER COMMISSIONERS  
 416 North State Street  
 1321 Jackson, Mississippi 39201

WATER WELL DRILLERS LOG

June 7 1976 Grenn Water Well Cont. Lincoln  
 date well completed firm name county well located

LANDOWNER: Kenneth Warrick Rt. 2, Box 35 Bogue Chitto, Miss. (mailing address)	description of formations encountered Citronelle	from 0	to 60
<b>WELL LOCATION:</b>			
sec. <u>23</u> T <u>6</u> N R. <u>7</u> E <div style="margin-left: 100px;">S W</div>			
5 miles S of Brookhaven <div style="margin-left: 10px;">(distance) (direction) (nearest town)</div>			
<b>WELL PURPOSE:</b> home (home, irrigation, municipal, industrial)			
<b>WELL COMPLETION DATA:</b>			
(1) diameter (inches) <u>4</u>			
(2) total depth (feet) <u>60</u>			
(3) static water level (feet) <u>20</u> below top of ground.			
(4) casing <u>PVC</u> <u>48</u> (material) (depth) <u>4"</u> (size) if telescope see back.			
(5) screen <u>12'</u> <u>48'</u> (length) (depth to top) <u>.010</u> <u>PVC</u> (size) (material)			
(6) pump <u>did not install</u> (HP) (yield gpm)			
(type power)			
(7) electric log <u>no</u> (yes or no)			
(organization running log)			
(8) how well bottom plugged <u>Back wash valve</u>			
DRILLERS REMARKS:			


RECEIVED

AUG 9 - 1976

MISS. BD. OF WATER COMM

If well telescopes please sketch and show depths.

GROUND LEVEL

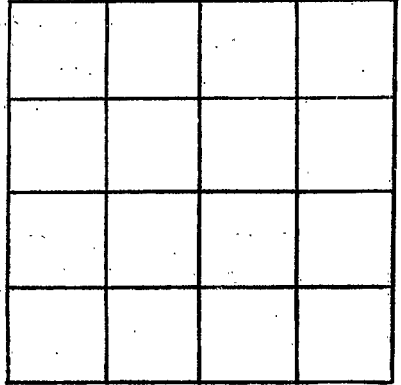

SECTION \_\_\_\_\_

Please indicate well location X.

ADDITIONAL INFORMATION

A series of 20 horizontal lines for recording additional information.

If more than one screen, show locations of each on sketch.