

Lincoln
 L 2004
 11/12/76

MISSISSIPPI
 BOARD OF WATER COMMISSIONERS
 416 North State Street
 Jackson, Mississippi 39201

WATER WELL DRILLERS LOG

11-12-76 19 Grenn Water Well Cont. Lincoln
 date well completed firm name county well located


LANDOWNER: <u>Horace McDaniel</u>	description of formations encountered	from	to
Route 5 Brookhaven, Miss. (mailing address)			
WELL LOCATION:			
sec. <u>4</u> T. <u>6</u> N. R. <u>7</u> E			
<u>3</u> miles SW of Brookhaven (distance) (direction) (nearest town)			
WELL PURPOSE: <u>home</u> (home, irrigation, municipal, industrial)			
WELL COMPLETION DATA:			
(1) diameter (inches) <u>6"</u>			
(2) total depth (feet) <u>81'</u>			
(3) static water level (feet) <u>51</u> below top of ground.			
(4) casing <u>PVC</u> , <u>75'</u> (material) (depth) <u>4"</u> (size) if telescope see back.			
(5) screen <u>6'</u> , <u>75'</u> (length) (depth to top) <u>.010</u> , <u>PVC</u> (size) (material)			
(6) pump <u>1/2</u> sub <u>10</u> (HP) (yield gpm) <u>electricity</u> (type power)			
(7) electric log <u>no</u> (yes or no) (organization running log)			
(8) how well bottom plugged <u>back wash valve</u>			
DRILLERS REMARKS:			

RECEIVED
 DEC 22 1976

MISS. DEPT. OF WATER CONTROL

If well telescopes please sketch and show depths.

GROUND LEVEL

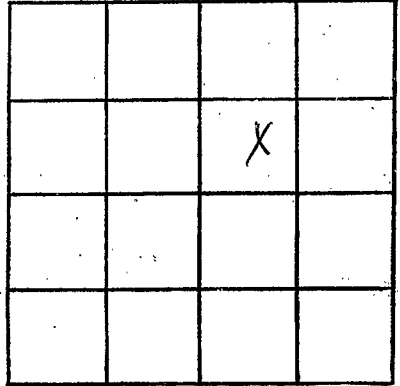

SECTION 4

Please indicate well location X.

ADDITIONAL INFORMATION

If more than one screen, show locations of each on sketch.