

Lincoln
L 2005
11/22/76

MISSISSIPPI
 BOARD OF WATER COMMISSIONERS
 416 North State Street
 Jackson, Mississippi 39201

WATER WELL DRILLERS LOG

1122 ¹³² 76 Grenn Water Well Cont. Lincoln
 date well completed firm name county well located


LANDOWNER:	description of fomations encountered	from	to
Mervin Smith Route 5 Brookhaven, Miss. (mailing address)	Citronelle	1	80
WELL LOCATION: sec. <u>9</u> T. <u>6</u> N. R. <u>7</u> E S. W. <u>3</u> miles <u>SW</u> of <u>Brookhaven</u> (distance) (direction) (nearest town)			
WELL PURPOSE: <u>home</u> (home, irrigation, municipal, industrial)			
WELL COMPLETION DATA: (1) diameter (inches) <u>6"</u> (2) total depth (feet) <u>80</u> (3) static water level (feet) <u>45</u> below above top of ground. (4) casing <u>PVC</u> <u>74</u> (material) (depth) <u>4"</u> (size) if telescope see back. (5) screen <u>6'</u> <u>74'</u> (length) (depth to top) <u>0.010</u> <u>PVC</u> (size) (material) (6) pump <u>1/2 sub</u> <u>10</u> (HP) (yield gpm) <u>electricity</u> (type power) (7) electric log <u>no</u> (yes or no) <u>(organization running log)</u>			
(8) how well bottom plugged <u>back wash valve</u>			
DRILLERS REMARKS:			

RECEIVED
 DEC 22 1976

MISS. Bd. OF WATER COMM.

If well telescopes please sketch and show depths.

GROUND LEVEL

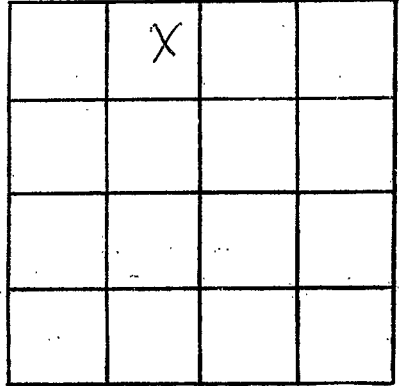

SECTION 9

Please indicate well location X.

ADDITIONAL INFORMATION

If more than one screen, show locations of each on sketch.