

Lincoln  
L 2006  
Nov. 17, 1976

MISSISSIPPI  
 BOARD OF WATER COMMISSIONERS  
 416 North State Street  
 Jackson, Mississippi 39201

WATER WELL DRILLERS LOG

Nov. 17 1976 Grenn Water Well Cont. Lincoln  
 date well completed firm name county well located


LANDOWNER: <u>Ronald Chauvin</u>	description of formations encountered	from	to
<u>Route 5</u>			
<u>Brookhaven, Miss.</u>			
(mailing address)			
WELL LOCATION:			
sec. <u>11</u> T. <u>6</u> (N) R. <u>7</u> (E)			
<u>4 1/2</u> miles <u>S</u> of <u>Brookhaven</u>			
(distance) (direction) (nearest town)			
WELL PURPOSE: <u>home</u>			
(home, irrigation, municipal, industrial)			
WELL COMPLETION DATA:			
(1) diameter (inches) <u>6"</u>			
(2) total depth (feet) <u>70'</u>			
(3) static water level (feet) <u>50</u> <sup>below</sup> <del>above</del> top of ground.			
(4) casing <u>PVC</u> <u>64'</u>			
(material) (depth)			
<u>4"</u> if telescope see back.			
(size)			
(5) screen <u>6'</u> <u>64'</u>			
(length) (depth to top)			
<u>.010</u> <u>PVC</u>			
(size) (material)			
(6) pump <u>1/2 sub</u> <u>10</u>			
(HP) (yield gpm)			
<u>electricity</u>			
(type power)			
(7) electric log <u>no</u>			
(yes or no)			
(organization running log)			
(8) how well bottom plugged <u>back wash valve</u>			
DRILLERS REMARKS:			

RECEIVED  
 DEC 22 1976

MISS. Bd. of WATER COMMISSIONERS

If well telescopes please sketch and show depths.

GROUND LEVEL

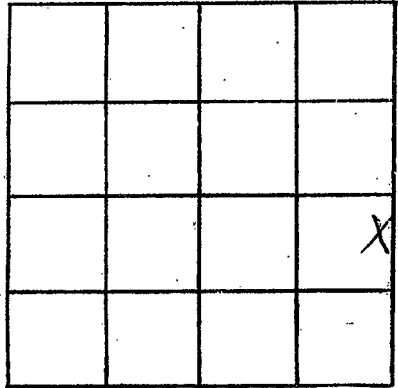

SECTION 11

Please indicate well location X.

ADDITIONAL INFORMATION

Lined area for additional information.

If more than one screen, show locations of each on sketch.