

Lincoln
L 2007
2-9-77

MISSISSIPPI
 BOARD OF WATER COMMISSIONERS
 416 North State Street
 130 Jackson, Mississippi 39201

WATER WELL DRILLERS LOG

Feb. 9 19 77 Grenn Water Well Cont. Lincoln
 date well completed firm name county well located

LANDOWNER: <u>Homer Laird</u>	description of formations encountered	from	to
<u>Route 5</u>			
<u>Brookhaven, Miss.</u> (mailing address)			
WELL LOCATION:			
sec <u>7</u> ^W T <u>6</u> N R <u>7</u> E S W			
<u>6</u> miles SW of <u>Brookhaven</u> (distance) (direction) (nearest town)			
WELL PURPOSE: <u>home</u> (home, irrigation, municipal, industrial)			
WELL COMPLETION DATA:			
(1) diameter (inches) <u>6</u>			
(2) total depth (feet) <u>50</u>			
(3) static water level (feet) <u>24</u> <u>below</u> top of ground.			
(4) casing <u>PVC</u> <u>38</u> (material) (depth)			
<u>4</u> (size) if telescope see back.			
(5) screen <u>12</u> <u>38</u> (length) (depth to top)			
<u>.010</u> <u>PVC</u> (size) (material)			
(6) pump <u>1/2</u> sub <u>10</u> (HP) (yield gpm)			
<u>electricity</u> (type power)			
(7) electric log <u>no</u> (yes or no)			
<u>(organization running log)</u>			
(8) how well bottom plugged <u>back wash valve</u>			
DRILLERS REMARKS:			


RECEIVED

MAR 25 1977

MISS. RD. OF WATER COMM.

If well telescopes please sketch and show depths.

GROUND LEVEL

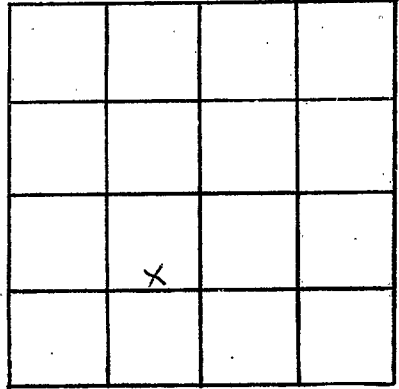

SECTION 7

Please indicate well location X.

ADDITIONAL INFORMATION

If more than one screen, show locations of each on sketch.