

Lincoln
L 2009
June 7, 1977

MISSISSIPPI
BOARD OF WATER COMMISSIONERS
416 North State Street
130 Jackson, Mississippi 39201

WATER WELL DRILLERS LOG

June 7 1977 Grenn Water welll Cont. Lincoln
date well completed firm name county well located


LANDOWNER: Edward Smith Route 5 Brookhaven, Miss. (mailing address)	description of formations encountered citronelle	from 1	to 82
WELL LOCATION:			
sec. 9 T 6 N R 7 E S W			
3 miles SW of Brookhaven (distance) (direction) (nearest town)			
WELL PURPOSE: home (home, irrigation, municipal, industrial)			
WELL COMPLETION DATA:			
(1) diameter (inches) 6			
(2) total depth (feet) 82			
(3) static water level (feet) 45 below top of ground. above			
(4) casing PVC 76 (material) (depth)			
4" If telescope see back. (size)			
(5) screen 6' 76' (length) (depth to top)			
.010 PVC (size) (material)			
(6) pump 1/2 HP sub 10 (HP) (yield gpm)			
electricity (type power)			
(7) electric log no (yes or no)			
(organization running log)			
(8) how well bottom plugged back wash valve			
DRILLERS REMARKS:			

RECEIVED
AUG 21 1977

MISS. BD. OF WATER COMM

If well telescopes please sketch and show depths.

GROUND LEVEL

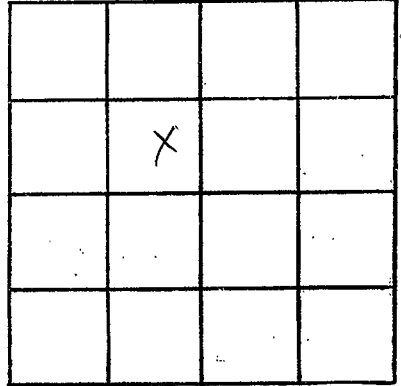

SECTION 9

Please indicate well location X.

ADDITIONAL INFORMATION

If more than one screen, show locations of each on sketch.