

Lincoln  
L 2010  
June 18, 1977

MISSISSIPPI  
 BOARD OF WATER COMMISSIONERS  
 416 North State Street  
 Jackson, Mississippi 39201

WATER WELL DRILLERS LOG

June 18 1977 Grenn Water Well Cont. Lincoln  
 date well completed firm name county well located


LANDOWNER: Charles Nettles Route 3, Box 174A Bogue Chitto, Miss. (mailing address)	description of formations encountered Citronelle	from 1	to 63
<b>WELL LOCATION:</b>			
sec. <u>7</u> T. <u>6</u> N. R. <u>7</u> E. S. --- W. ---			
<u>5</u> miles <u>NW</u> of <u>Bogue Chitto</u> (distance) (direction) (nearest town)			
<b>WELL PURPOSE:</b> <u>home</u> (home, irrigation, municipal, industrial)			
<b>WELL COMPLETION DATA:</b>			
(1) diameter (inches) <u>6</u>			
(2) total depth (feet) <u>63</u>			
(3) static water level (feet) <u>35</u> <u>below</u> <u>above</u> top of ground.			
(4) casing <u>PVC</u> <u>51</u> (material) (depth) <u>4"</u> (size) if telescope see back.			
(5) screen <u>12"</u> <u>51"</u> (length) (depth to top) <u>.010</u> <u>PVC</u> (size) (material)			
(6) pump <u>1/2</u> HP sub <u>10</u> (HP) (yield gpm) <u>electricity</u> (type power)			
(7) electric log <u>no</u> (yes or no)  (organization running log)			
(8) how well bottom plugged <u>back wash valve</u>			
<b>DRILLERS REMARKS:</b>			

**RECEIVED**  
 AUG 24 1977

BD. OF WATER COMM.

If well telescopes please  
sketch and show depths.

GROUND LEVEL

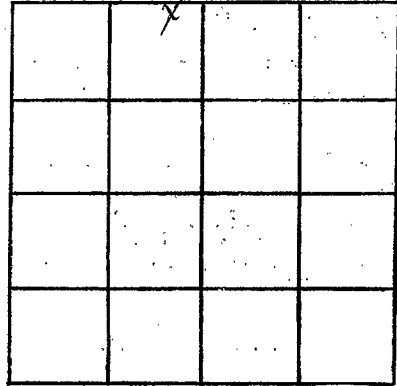

SECTION 7

Please indicate well location X.

ADDITIONAL INFORMATION

If more than one screen,  
show locations of each on sketch.