

LINCOLN
L 2012
9-9-77

MISSISSIPPI
BOARD OF WATER COMMISSIONERS
416 North State Street
Jackson, Mississippi 39201

WATER WELL DRILLERS LOG

MISSISSIPPI
BOARD OF WATER COMMISSIONERS
416 North State Street
Jackson, Mississippi 39201

Sept. 9 19 77 Grenn Water Well Cont. Lincoln
date well completed firm name county well located

LANDOWNER:	description of formations encountered	from	to
Freddie Andrew Route 2, Box 21 Bogue Chitto, Miss. (mailing address)	Citronelle	1	60
WELL LOCATION: sec. 24 T. 6 N. R. 7 E. 3 miles N Bogue Chitto (distance) (direction) (nearest town)			
WELL PURPOSE: home (home, irrigation, municipal, industrial)			
WELL COMPLETION DATA: (1) diameter (inches) 6 (2) total depth (feet) 60 (3) static water level (feet) 43 below above top of ground. (4) casing PVC 64' (material) (depth) 4" if telescope see back. (size) (5) screen 6' 64' (length) (depth to top) .010 PVC (size) (material) (6) pump 1/2 sub 10 (HP) (yield gpm) electricity (type power) (7) electric log no (yes or no). (organization running log) (8) how well bottom plugged bask wash valve			
DRILLERS REMARKS:			


RECEIVED

OCT 26 1977

MISS. BD. OF WATER COM. M.

If well telescopes please sketch and show depths.

GROUND LEVEL

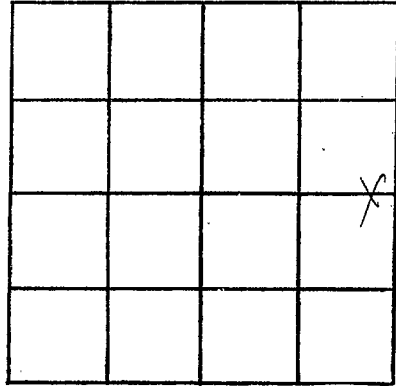

SECTION 24

Please indicate well location X.

ADDITIONAL INFORMATION

A series of horizontal lines for writing additional information.

If more than one screen, show locations of each on sketch.