

LINCOLN
L 2016
June 1, 1979

MISSISSIPPI
BOARD OF WATER COMMISSIONERS
416 North State Street
Jackson, Mississippi 39201

WATER WELL DRILLERS LOG

June 1 1979 Grenn Water Well Cont. Lincoln

date well completed 1979 firm name county well located

LANDOWNER	description of formations encountered	from	to
Lindeal Greer	clay	1	20
Rt, 2 Bogue Chitto, Miss.	sabd & gravel	20	58
	white clay	58	70
(mailing address)	blue clay	70	180
	sand	180	195
WELL LOCATION:			
sec. 25 T. 6 N. R. 7 E			
2 N Bogue Chitto			
(distance) miles (direction) of (nearest town)			
WELL PURPOSE: home			
(home, irrigation, municipal, industrial)			
WELL COMPLETION DATA:			
(1) diameter (inches) 4			
(2) total depth (feet) 195			
(3) static water level (feet) 75 below top of ground.			
(4) casing Pvc 183 (material) (depth) 4" (size) if telescope see back.			
(5) screen 12' (length) 183' (depth to top) .010 PVC (size) (material)			
(6) pump 3/4 HP sub 10 (HP) (yield gpm) electricity (type power)			
(7) electric log no (yes or no)			
(organization running log)			
(8) how well bottom plugged back wash valve			
DRILLERS REMARKS:			


Miss. Board of Water Comm.

JUL 9 1979

RECEIVED

If well telescopes please sketch and show depths.

GROUND LEVEL

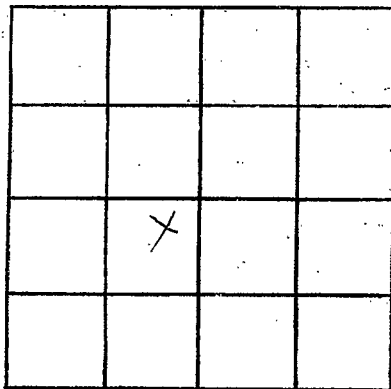

SECTION 25

Please indicate well location X.

ADDITIONAL INFORMATION

If more than one screen, show locations of each on sketch.