

Lincoln
L 2018
7-30-80

MISSISSIPPI
BOARD OF WATER COMMISSIONERS
416 North State Street
Jackson, Mississippi 39201

WATER WELL DRILLERS LOG

7-30 1980 Fitzgerald Well Serv Lincoln
date well completed firm name county well located

LANDOWNER:
Helen Edwards -
R.R. Birchman
(mailing address)

description of formations encountered	from	to
Red Clay	0	20
Red Sand	20	60
Coarse Sand & gravel	60	85

WELL LOCATION:
sec. 22 T. 6N R. 7E
6 miles SW of Birchman
(distance) (direction) (nearest town)

WELL PURPOSE:
Home
(home, irrigation, municipal, industrial)

- WELL COMPLETION DATA:
- (1) diameter (inches) 4
 - (2) total depth (feet) 85
 - (3) static water level (feet) 50 below top of ground.
 - (4) casing PVC 77 (material) (depth)
4 (size) if telescope see back.
 - (5) screen 8 77 (length) (depth to top)
4 (size) PVC (material)
 - (6) pump 1/2 10 (HP) (yield gpm)
Eli (type power)
 - (7) electric log yes (yes or no)
 - (organization running log)
 - (8) how well bottom plugged Sand/Mk

DRILLERS REMARKS:


DEPT. OF NATURAL RESOURCES
BUREAU OF LAND & WATER RESOURCES

SEP 8 - 1980

RECEIVED

If well telescopes please sketch and show depths.

GROUND LEVEL

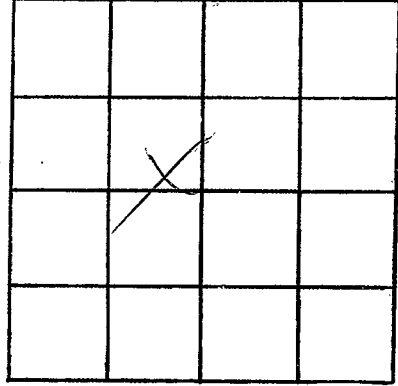

SECTION 22

Please indicate well location X.

ADDITIONAL INFORMATION

If more than one screen,
show locations of each on sketch.