

Lincoln
L 2002
11-13-80

MISSISSIPPI
BOARD OF WATER COMMISSIONERS
416 North State Street
Jackson, Mississippi 39201

WATER WELL DRILLERS LOG

Nov. 13 19 80 Brenn Water Well Cont. Lincoln
date well completed firm name county well located

LANDOWNER: Andy Leggett
Route 3, Box 15
Bogue Chitto, Ms.
(mailing address)

description of fomations encountered	from	to
Citronelle	1	132

WELL LOCATION:
sec. 33 T 6 N R 7 E
S W W
3 miles - W of Bogue Chitto
(distance) (direction) (nearest town)

WELL PURPOSE: home
(home, irrigation, municipal, industrial)

WELL COMPLETION DATA:

(1) diameter (inches) 4

(2) total depth (feet) 132

(3) static water level (feet) 80 below above top of ground.

(4) casing PVC 122
(material) (depth)
4 (size) If telescope see back.

(5) screen 10' 122'
(length) (depth to top)
.010 PVC
(size) (material)

(6) pump 1/2 hp 8
(HP) (yield gpm)

electricity
(type power)

(7) electric log no
(yes or no)

(organization running log)

(8) how well bottom plugged
back wash valve

DRILLERS REMARKS:


DEPT. OF NATURAL RESOURCES
BUREAU OF LAND & WATER RESOURCES

JAN 12 1981

RECEIVED

If well telescopes please sketch and show depths.

GROUND LEVEL

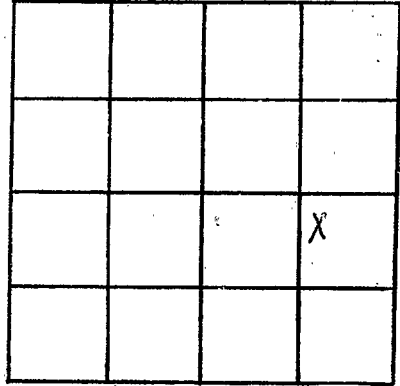

SECTION 33

Please indicate well location X.

ADDITIONAL INFORMATION

If more than one screen,
show locations of each on sketch.