

Lincoln
L 2023
4-16-81

MISSISSIPPI
BOARD OF WATER COMMISSIONERS
416 North State Street
Jackson, Mississippi 39201

WATER WELL DRILLERS LOG

4-16 1981 *Fitzgerald Well Co* Lincoln
date well completed firm name county well located


LANDOWNER:	description of formations encountered	from	to
<i>Jerry Sullivan</i>			
<i>P.R. Brockman</i> (mailing address)	<i>Red Clay</i>	<i>13</i>	<i>20</i>
	<i>Red Sand</i>	<i>20</i>	<i>50</i>
WELL LOCATION:	<i>Coarse Sandstone</i>	<i>50</i>	<i>60</i>
sec. <i>11</i> T. <i>6</i> (N) S. R. <i>7</i> (E) W. <i>4</i> miles <i>S</i> of <i>Brookhaven</i> (distance) (direction) (nearest town)			
WELL PURPOSE: <i>Home</i> (home, irrigation, municipal, industrial)			
WELL COMPLETION DATA:			
(1) diameter (inches) <i>4</i>			
(2) total depth (feet) <i>60</i>			
(3) static water level (feet) <i>42</i> below above top of ground.			
(4) casing <i>ASL</i> <i>52</i> , (material) (depth) <i>4</i> (size) If telescope see back.			
(5) screen <i>8</i> <i>52</i> (length) (depth to top)			
(6) pump <i>1/2</i> <i>ASL</i> (HP) (material)			
(6) pump <i>1/2</i> <i>10</i> (HP) (yield gpm)			
(6) pump <i>also</i> (type power)			
(7) electric log <i>no</i> (yes or no)			
(7) electric log (organization running log)			
(8) how well bottom plugged <i>plugged</i>			
DRILLERS REMARKS:			

DEPT. OF NATURAL RESOURCES
BUREAU OF LAND & WATER RESOURCES

APR 29 1981
RECEIVED

If well telescopes please sketch and show depths.

GROUND LEVEL

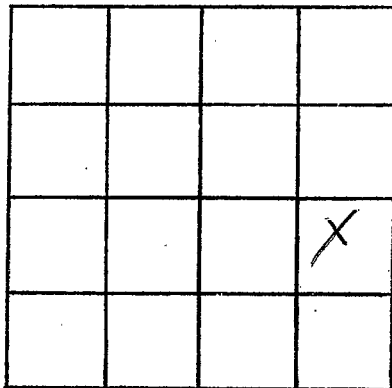

SECTION 11

Please indicate well location X.

ADDITIONAL INFORMATION

If more than one screen, show locations of each on sketch.