

Lincoln
L 2024
8-26-80

MISSISSIPPI
BOARD OF WATER COMMISSIONERS
416 North State Street
Jackson, Mississippi 39201

WATER WELL DRILLERS LOG

Aug 26 1980 Rumer wells Lincoln
date well completed firm name county well located

LANDOWNER:
Ferry Prother
Rt Brookhaven
(mailing address)

description of formations encountered	from	to
<u>sandy clay</u>	<u>0</u>	<u>17</u>
<u>red sand</u>	<u>17</u>	<u>26</u>
<u>sea gravel sand</u>	<u>26</u>	<u>87</u>

WELL LOCATION:
sec. 10 T. 6 N R. 7 E
5 miles S-SW of Brookhaven
(distance) (direction) (nearest town)

WELL PURPOSE: Trailer
(home, irrigation, municipal, industrial)

WELL COMPLETION DATA:

(1) diameter (inches) 4"

(2) total depth (feet) 87

(3) static water level (feet) 60 below top of ground.

(4) casing plastic pattern
(material) (depth)

(size) if telescope see back.

(5) screen 5' 82'
(length) (depth to top)

4" plastic
(size) (material)

(6) pump 1/2 10
(HP) (yield gpm)

shot
(type power)

(7) electric log no
(yes or no)

(organization running log)

(8) how well bottom plugged Bob Wash Value

DRILLERS REMARKS:


DEPT. OF NATURAL RESOURCES
BUREAU OF LAND & WATER RESOURCES

MAY 14 1981

RECEIVED

If well telescopes please sketch and show depths.

GROUND LEVEL

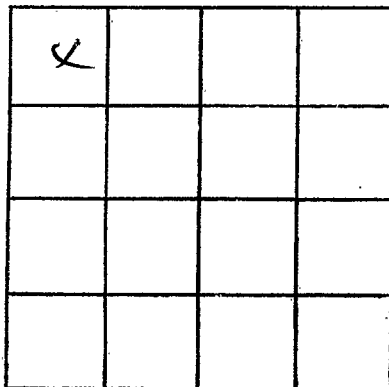

SECTION 10

Please indicate well location X.

ADDITIONAL INFORMATION

If more than one screen, show locations of each on sketch.