

Lincoln  
L-2027  
3-31-81

MISSISSIPPI DEPARTMENT

Bureau of Land and Water

Southport Mall

P.O. Box 10631

Jackson, Mississippi 39209

WATER WELL DRILLERS LOG

March 31 1981 Grenn Water Well Cont. Lincoln  
date well completed firm name county well located

LANDOWNER: Bill Thomas  
Route 4, Box 130  
Bogue Chitto, Miss.  
(mailing address)

description of formations encountered.	from	to
clay	1	20
sand & gravel	20	60
white clay	60	99
fine sand	90	120
blue clay	120	140
white clay	140	170
sand	170	210


WELL LOCATION:  
sec. 11 T 6 N R 7 E  
S W  
4 miles S of Brookhaven  
(distance) (direction) (nearest town)

WELL PURPOSE: home  
(home, irrigation, municipal, industrial)

WELL COMPLETION DATA:


- (1) diameter (inches) 4
- (2) total depth (feet) 210
- (3) static water level (feet) 60 below above top of ground.
- (4) casing PVC, 200,  
(material) (depth)  
4"  
(size) if telescope see back.
- (5) screen 10', 200;  
(length) (depth to top)  
.010, PVC  
(size) (material)
- (6) pump 1/2 sub 8  
(HP) (yield gpm)  
electricity  
(type power)
- (7) electric log no  
(yes or no)  
(organization running log)
- (8) how well bottom plugged  
back wash valve

DRILLERS REMARKS:

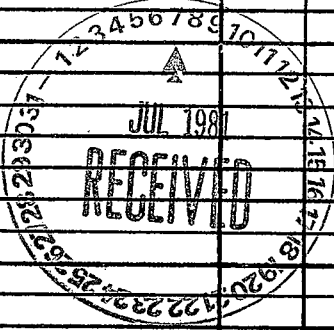

If well telescopes please sketch and show depths.

GROUND LEVEL

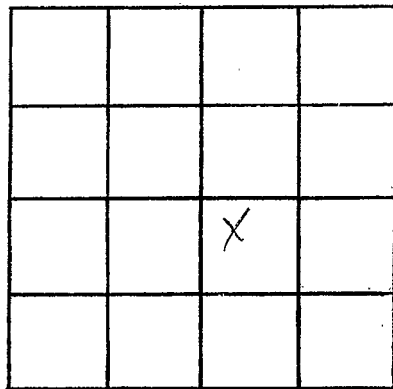

SECTION 11

Please indicate well location X.

ADDITIONAL INFORMATION

If more than one screen,  
show locations of each on sketch.