

MISSISSIPPI DEPARTMENT OF NATURAL RESOURCES

Bureau of Land and Water Resources

Southport Mall

P.O. Box 10631

Jackson, Mississippi 39209

WATER WELL DRILLERS LOG

Lincoln  
L 2028  
3-24-81

March 24 1981 *Rever Mr Lincoln*  
date well completed firm name county well located

LANDOWNER:  
*Cedric May*  
*Breakhanen*  
(mailing address)


description of formations encountered	from	to
<i>sandy clay</i>	<i>0</i>	<i>14</i>
<i>Red sand</i>	<i>14</i>	<i>45</i>
<i>gravel &amp; sand</i>	<i>45</i>	<i>58</i>

WELL LOCATION:  
sec. *10* T-*6* N R-*7* E  
*5* miles *S-SW* of *Breakhanen*  
(distance) (direction) (nearest town)

WELL PURPOSE: *Trailer*  
(home, irrigation, municipal, industrial)

- WELL COMPLETION DATA:
- (1) diameter (inches) *4"*
  - (2) total depth (feet) *58*
  - (3) static water level (feet) *42'* below top of ground.
  - (4) casing *plastic bottom*  
(material) (depth)
  - (size) if telescope see back.
  - (5) screen *5'* *53'*  
(length) (depth to top)
  - 4"* *plastic*  
(size) (material)
  - (6) pump *glub* *10*  
(HP) (yield gpm)
  - check*  
(type power)
  - (7) electric log *no*  
(yes or no)
  - (organization running log)
  - (8) how well bottom plugged *back wash*

DRILLERS REMARKS:  
*/*

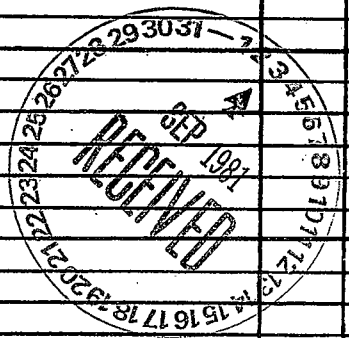

If well telescopes please sketch and show depths.

GROUND LEVEL

	X		

SECTION 10

Please indicate well location X.

ADDITIONAL INFORMATION

If more than one screen, show locations of each on sketch.