

MISSISSIPPI DEPARTMENT OF NATURAL RESOURCES

Bureau of Land and Water Resources

Southport Mall

P.O. Box 10631

Jackson, Mississippi 39209

WATER WELL DRILLERS LOG

LINCOLN
L 2029
8-16-81

8-16 1981 Grenn Water Well Cont. Lincoln  
 date well completed firm name county well located

LANDOWNER:	description of formations encountered	from	to
Stanford Qualls	Clay	1	30
P.O. Box 889'	Sand & Gravel	30	84
Brookhaven, MISS (mailing address)	white clay	84	140
	Blue Clay	140	170
	sand	170	224
<b>WELL LOCATION:</b>			
sec. <u>2</u> T. <u>6</u> <u>N</u> R. <u>7</u> <u>E</u>			
4 miles South of Brookhaven			
(distance) (direction) (nearest town)			
<b>WELL PURPOSE:</b> home			
(home, irrigation, municipal, industrial)			
<b>WELL COMPLETION DATA:</b>			
(1) diameter (inches) <u>4</u>			
(2) total depth (feet) <u>224</u>			
(3) static water level (feet) <u>75</u> below above top of ground.			
(4) casing <u>PVC</u> <u>214</u>			
(material) (depth)			
4" (size) if telescope see back.			
(5) screen <u>10'</u> <u>214'</u>			
(length) (depth to top)			
<u>.010</u> <u>PVC</u>			
(size) (material)			
(6) pump <u>1/2 sub.</u> <u>8</u>			
(HP) (yield gpm)			
<u>electricity</u>			
(type power)			
(7) electric log <u>no</u>			
(yes or no)			
<u></u>			
(organization running log)			
(8) how well bottom plugged <u>back wash valve</u>			
DRILLERS REMARKS:			


DEPT. OF NATURAL RESOURCES  
 BUREAU OF LAND & WATER RESOURCES

OCT - 1 1981

RECEIVED

If well telescopes please sketch and show depths.

GROUND LEVEL

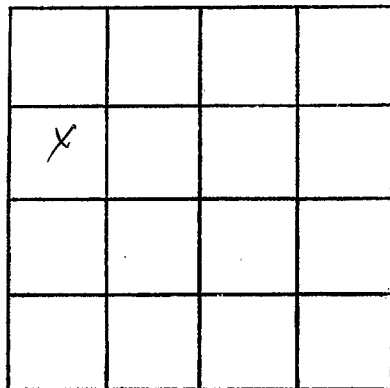

SECTION 2

Please indicate well location X.

ADDITIONAL INFORMATION

If more than one screen,  
show locations of each on sketch.