

Lincoln
L 2031
10-30-81

MISSISSIPPI DEPARTMENT OF NATURAL RESOURCES
 Bureau of Land and Water Resources
 Southport Mall
 P.O. Box 10631
 Jackson, Mississippi 39209
WATER WELL DRILLERS LOG

Oct. 30 19 81 Grenn Water Well Lincoln
 date well completed firm name county well located

LANDOWNER: Tony Laird
Route 2, Box 303
Brookhaven, Ms.
 (mailing address)

description of formations encountered	from	to
	<u>Citronelle</u>	<u>1</u>

WELL LOCATION:
 sec. 11 T 6 N R 7 E
 S W
5 miles S of Brookhaven
 (distance) (direction) (nearest town)

WELL PURPOSE: home
 (home, irrigation, municipal, industrial)

- WELL COMPLETION DATA:
- (1) diameter (inches) 4
 - (2) total depth (feet) 140
 - (3) static water level (feet) 70 below top of ground.
 - (4) casing PVC 130
 (material) (depth)
4" if telescope see back.
 (size)
 - (5) screen 10' 130'
 (length) (depth to top)
.010 PVC
 (size) (material)
 - (6) pump 1/2 sub 8
 (HP) (yield gpm)
electricity
 (type power)
 - (7) electric log no
 (yes or no)
no
 (organization running log)
 - (8) how well bottom plugged back wash valve

DRILLERS REMARKS: _____


DEPT. OF NATURAL RESOURCES
 BUREAU OF LAND & WATER RESOURCES

DEC 11 1981

RECEIVED

If well telescopes please sketch and show depths.

GROUND LEVEL

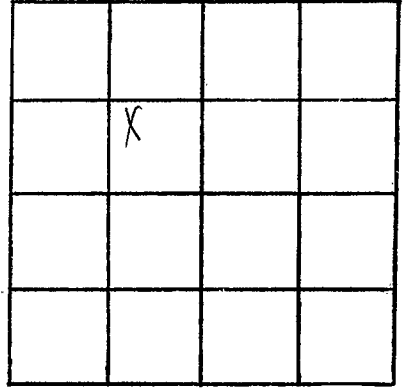

SECTION 11

Please indicate well location X.

ADDITIONAL INFORMATION

If more than one screen,
show locations of each on sketch.