

Lincoln  
L  
236

MISSISSIPPI DEPARTMENT OF NATURAL RESOURCES  
 Bureau of Land and Water Resources  
 Southport Mall  
 P.O. Box 10631  
 Jackson, Mississippi 39209  
**WATER WELL DRILLERS LOG**


June 7 19 82 Grenn Water Well Lincoln  
 date well completed firm name county well located

LANDOWNER: Raymond Smith 808 Pine Knoll Cts Jackson, Ms. (mailing address)	description of fomations encountered Citronelle	from 1	to 70
<b>WELL LOCATION:</b>			
sec. <u>4</u> T <u>6</u> N R <u>7</u> E S W			
<u>4</u> miles S of Brookhaven (distance) (direction) (nearest town)			
<b>WELL PURPOSE:</b> home (home, irrigation, municipal, industrial)			
<b>WELL COMPLETION DATA:</b>			
(1) diameter (inches) <u>4</u>			
(2) total depth (feet) <u>70</u>			
(3) static water level (feet) <u>23</u> below above top of ground.			
(4) casing <u>PVC</u> , <u>60</u> (material) (depth) <u>4"</u> if telescope see back. (size)			
(5) screen <u>10'</u> , <u>60'</u> (length) (depth to top) <u>.010</u> PVC (size) (material)			
(6) pump <u>did not install</u> (HP) (yield gpm)  (type power)			
(7) electric log <u>no</u> (yes or no)  (organization running log)			
(8) how well bottom plugged <u>back wash valve</u>			
DRILLERS REMARKS:			

DEPT. OF NATURAL RESOURCES  
 BUREAU OF LAND & WATER RESOURCES  
 AUG 20 1982  
**RECEIVED**

If well telescopes please  
sketch and show depths.

GROUND LEVEL

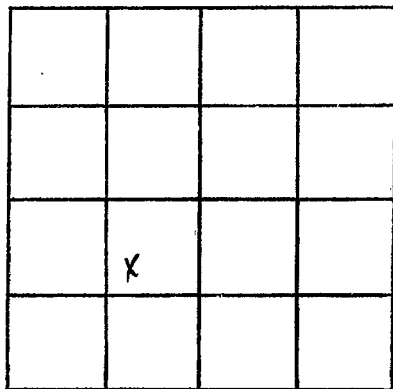

SECTION 4

Please indicate well location X.

ADDITIONAL INFORMATION

If more than one screen,  
show locations of each on sketch.