

Lincoln
L
2038

MISSISSIPPI DEPARTMENT OF NATURAL RESOURCES
 Bureau of Land and Water Resources
 Southport Mall
 P.O. Box 10631
 Jackson, Mississippi 39209
WATER WELL DRILLERS LOG

July 5 1982 Grenn Water Well Lincoln
 date well completed firm name county well located

| LANDOWNER: Greg Smith Route 4, Box 18 | description of formations encountered Citronelle | from 1 | to 68 |
|--|---|-----------|----------|
| Bogue Chitto, Ms. (mailing address) | | | |
| WELL LOCATION: sec. <u>34</u> T <u>6</u> N R <u>7</u> E S W <u>2</u> miles <u>Nw</u> of <u>Bogue Chitto</u> (distance) (direction) (nearest town) | | | |
| WELL PURPOSE: <u>home</u> (home, irrigation, municipal, industrial) | | | |
| WELL COMPLETION DATA: (1) diameter (inches) <u>4</u> (2) total depth (feet) <u>68</u> (3) static water level (feet) <u>42</u> below top of ground. (4) casing <u>PVC</u> <u>58'</u> (material) (depth) <u>4"</u> (size) if telescope see back. (5) screen <u>10'</u> <u>58'</u> (length) (depth to top) <u>.010 i</u> <u>PVC</u> (size) (material) (6) pump <u>did not install</u> (HP) (yield gpm) _____ (type power) (7) electric log <u>no</u> (yes or no) _____ (organization running log) (8) how well bottom plugged _____ <u>back wash valve</u> | | | |
| DRILLERS REMARKS: _____ _____ _____ | | | |


DEPT. OF NATURAL RESOURCES
 BUREAU OF LAND & WATER RESOURCES

SEP 30 1982

RECEIVED

If well telescopes please sketch and show depths.

GROUND LEVEL

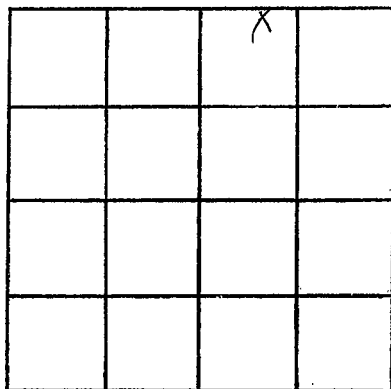

SECTION 34

Please indicate well location X.

ADDITIONAL INFORMATION

If more than one screen,
show locations of each on sketch.