

Lincoln  
L  
2080

MISSISSIPPI DEPARTMENT OF NATURAL RESOURCES  
Bureau of Land and Water Resources  
Southport Mall  
P.O. Box 10631  
Jackson, Mississippi 39209  
WATER WELL DRILLERS LOG

Aug. 26 19 82 Grenn Water Well Lincoln  
date well completed firm name county well located

LANDOWNER: Tommy McMurray

Rt. 4, Box 206B

Bogue Chitto, Ms.

(mailing address)

description of fomations encountered

Citronelle

from

1

to

1371

WELL LOCATION:

sec. 8 T 6 N R 7 E  
S W  
4 miles SW of Bogokhaven  
(distance) (direction) (nearest town)

WELL PURPOSE: home

(home, irrigation, municipal, industrial)

WELL COMPLETION DATA:

- (1) diameter (inches) 4
- (2) total depth (feet) 137
- (3) static water level (feet) 47 below above top of ground.
- (4) casing PVC, 127' (material), (depth)  
4" (size) if telescope see back.
- (5) screen 10' (length), 127' (depth to top)  
.010 PVC (size) (material)
- (6) pump 1/2 sub 8 (HP) (yield gpm)  
electricity (type power)
- (7) electric log no (yes or no)

(organization running log)

- (8) how well bottom plugged - back wash valve


DRILLERS REMARKS:

DEPT. OF NATURAL RESOURCES  
BUREAU OF LAND & WATER RESOURCES

SEP 30 1982  
RECEIVED

If well telescopes please sketch and show depths.

GROUND LEVEL

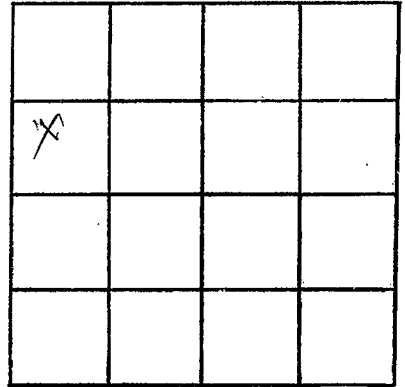

SECTION 8

Please indicate well location X.

ADDITIONAL INFORMATION

If more than one screen,  
show locations of each on sketch.