

Lincoln
L
2041

MISSISSIPPI DEPARTMENT OF NATURAL RESOURCES
Bureau of Land and Water Resources
Southport Mall
P.O. Box 10631
Jackson, Mississippi 39209
WATER WELL DRILLERS LOG

Sept. 15 1982 Grenn Water Well Lincoln
date well completed firm name county well located

LANDOWNER: E. J. Henley
Route 2
Bogue Chitto, Ms.
(mailing address)
WELL LOCATION:
sec. 14 T 6 N R 7 E
S W
4 miles North of Bogue Chitto
(distance) (direction) (nearest town)

description of formations encountered	from	to
Clay	1	20
sand & gravel	20	55
white clay	55	75
blue clay	75	200
white clay	200	210
sand	210	240

WELL PURPOSE: home
(home, irrigation, municipal, industrial)

- WELL COMPLETION DATA:
- (1) diameter (inches) 4
 - (2) total depth (feet) 240
 - (3) static water level (feet) 57 below above top of ground.
 - (4) casing PVC 230
(material) (depth)
4" (size) if telescope see back.
 - (5) screen 10' 230'
(length) (depth to top)
.010 PVC
(size) (material)
 - (6) pump did not install
(HP) (yield gpm)
(type power)
 - (7) electric log no
(yes or no)
(organization running log)
 - (8) how well bottom plugged back wash valve

DRILLERS REMARKS:


DEPT. OF NATURAL RESOURCES
BUREAU OF LAND & WATER RESOURCES

NOV 23 1982

RECEIVED

If well telescopes please sketch and show depths.

GROUND LEVEL

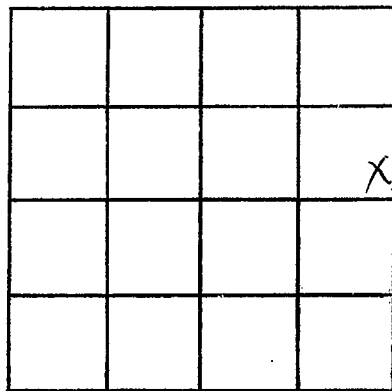

SECTION 14

Please indicate well location X.

ADDITIONAL INFORMATION

If more than one screen,
show locations of each on sketch.