

Lincoln  
L  
2043

MISSISSIPPI DEPARTMENT OF NATURAL RESOURCES  
Bureau of Land and Water Resources  
Southport Mall  
P.O. Box 10631  
Jackson, Mississippi 39209  
WATER WELL DRILLERS LOG

12-22-82 19 Green Water Well Lincoln  
date well completed firm name county well located

LANDOWNER:	description of formations encountered	from	to
<u>Pete Dixon</u> <u>Rt. 5, Box 247 B<sup>y</sup></u> <u>Brookhaven, Ms.</u> (mailing address)	<u>Citronelle</u>	<u>1</u>	<u>80</u>
<b>WELL LOCATION:</b>			
sec. <u>6</u> T <u>6</u> N R <u>7</u> E S W			
<u>6</u> miles <u>SW</u> of <u>Brookhaven</u> (distance) (direction) (nearest town)			
<b>WELL PURPOSE:</b> <u>none</u> (home, irrigation, municipal, industrial)			
<b>WELL COMPLETION DATA:</b>			
(1) diameter (inches) <u>4</u>			
(2) total depth (feet) <u>80</u>			
(3) static water level (feet) <u>54</u> below above top of ground.			
(4) casing <u>PVC</u> <u>70'</u> (material) (depth) <u>4"</u> if telescope see back. (size)			
(5) screen <u>10'</u> <u>70'</u> (length) (depth to top) <u>.010</u> <u>PVC</u> (size) (material)			
(6) pump <u>did not install</u> (HP) (yield gpm)  (type power)			
(7) electric log <u>no</u> (yes or no)  (organization running log)			
(8) how well bottom plugged <u>back wash valve</u>			
DRILLERS REMARKS:			


DEPT. OF NATURAL RESOURCES  
BUREAU OF LAND & WATER RESOURCES

FEB 28 1983

RECEIVED

If well telescopes please sketch and show depths.

GROUND LEVEL

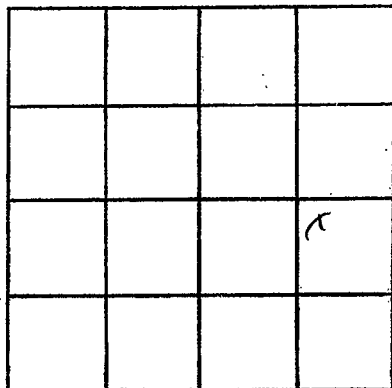

SECTION 6

Please indicate well location X.

ADDITIONAL INFORMATION

If more than one screen, show locations of each on sketch.