

Leaster
L
2057

MISSISSIPPI DEPARTMENT OF NATURAL RESOURCES
 Bureau of Land and Water Resources
 Southport Mall
 P.O. Box 10631
 Jackson, Mississippi 39209
WATER WELL DRILLERS LOG

July 18 1983 Gretn Water Well Lincoln
 date well completed firm name county well located


LANDOWNER:	description of fomations encountered	from	to
<u>James Jordan</u>	<u>Citronelle</u>	<u>1</u>	<u>74</u>
<u>Route 2</u>			
<u>Bogue Chitto, Ms.</u> (mailing address)			
WELL LOCATION:			
sec. <u>23</u> T <u>6</u> N R <u>7</u> E S W			
<u>3</u> miles N of <u>Bogue Chitto</u> (distance) (direction) (nearest town)			
WELL PURPOSE: <u>home</u> (home, irrigation, municipal, industrial)			
WELL COMPLETION DATA:			
(1) diameter (inches) <u>4</u>			
(2) total depth (feet) <u>74</u>			
(3) static water level (feet) <u>24</u> below above top of ground.			
(4) casing <u>PVC</u> , <u>64</u> , (material) (depth) <u>4"</u> (size) if telescope see back.			
(5) screen <u>10'</u> , <u>64'</u> (length) (depth to top) <u>.010</u> , <u>PVC</u> (size) (material)			
(6) pump <u>1/2</u> sub <u>8</u> (HP) (yield gpm) <u>electricity</u> (type power)			
(7) electric log <u>no</u> (yes or no) <u></u> (organization running log)			
(8) how well bottom plugged <u>back wash valve</u>			

DRILLERS REMARKS: _____

DEPT. OF NATURAL RESOURCES
 BUREAU OF LAND & WATER RESOURCES
 SEP - 1 1983
RECEIVED

If well telescopes please sketch and show depths.

GROUND LEVEL

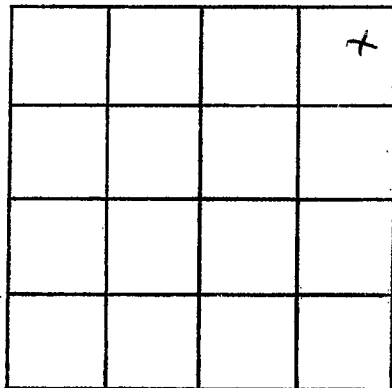

SECTION 2.3

Please indicate well location X.

ADDITIONAL INFORMATION

If more than one screen,
show locations of each on sketch.