

Lincoln
L2052

MISSISSIPPI DEPARTMENT OF NATURAL RESOURCES
Bureau of Land and Water Resources
Southport Mall
P.O. Box 10631
Jackson, Mississippi 39209
WATER WELL DRILLERS LOG


July 20 19 83 Grenn Water Well Lincoln
date well completed firm name county well located

LANDOWNER: Jesse Rippy	description of formations encountered	from	to
Route 2	Citronelle	1	95
Bogue Chitto, Ms. (mailing address)			
WELL LOCATION:			
sec. <u>22</u> T <u>6</u> N R <u>7</u> E S W			
<u>2</u> miles <u>NW</u> of <u>Brookhaven</u> (distance) (direction) (nearest town)			
WELL PURPOSE: <u>home</u> (home, irrigation, municipal, industrial)			
WELL COMPLETION DATA:			
(1) diameter (inches) <u>4</u>			
(2) total depth (feet) <u>95</u>			
(3) static water level (feet) <u>45</u> below above top of ground.			
(4) casing <u>PVC</u> , <u>85'</u> (material) (depth) <u>4"</u> (size) if telescope see back.			
(5) screen <u>10'</u> , <u>85'</u> (length) (depth to top) <u>.010</u> <u>PVC</u> (size) (material)			
(6) pump <u>1 sub</u> , <u>8</u> (HP) (yield gpm) <u>electricity</u> (type power)			
(7) electric log <u>no</u> (yes or no) <u></u> (organization running log)			
(8) how well bottom plugged <u>back wash valve</u>			
DRILLERS REMARKS: <u></u>			

MISSISSIPPI DEPARTMENT OF NATURAL RESOURCES
BUREAU OF LAND & WATER RESOURCES
SEP - 1 1983
RECEIVED

If well telescopes please sketch and show depths.

GROUND LEVEL

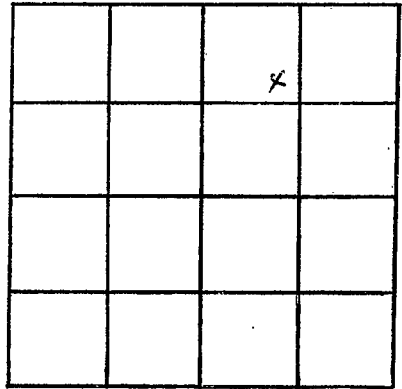

SECTION 22

Please indicate well location X.

ADDITIONAL INFORMATION

A series of horizontal lines for writing additional information.

If more than one screen, show locations of each on sketch.