

MISSISSIPPI DEPARTMENT OF NATURAL RESOURCES
 Bureau of Land and Water Resources
 Southport Mall
 P.O. Box 10631
 Jackson, Mississippi 39209
WATER WELL DRILLERS LOG

Lincoln
L
2056

4-16 19 84 Grenn Water Well Lincoln
 date well completed firm name county well located


LANDOWNER: <u>George Cowart</u> <u>Rt. 5</u>	description of formations encountered <u>Citronelle</u>	from <u>1</u>	to <u>58</u>
<u>Brookhaven, Ms.</u> (mailing address)			
WELL LOCATION: sec. <u>1</u> T. <u>6</u> N. R. <u>7</u> E S W <u>5</u> miles SW of <u>Brookhaven</u> (distance) (direction) (nearest town)			
WELL PURPOSE: <u>home</u> (home, irrigation, municipal, industrial)			
WELL COMPLETION DATA:			
(1) diameter (inches) <u>4</u>			
(2) total depth (feet) <u>58</u>			
(3) static water level (feet) <u>30</u> below above top of ground.			
(4) casing <u>PVC</u> , <u>48</u> (material), (depth) <u>4"</u> (size) if telescope see back.			
(5) screen <u>10'</u> , <u>48'</u> (length), (depth to top) <u>.010</u> , <u>PVC</u> (size), (material)			
(6) pump <u>1/2</u> sub <u>8</u> (HP), (yield gpm) <u>electricity</u> (type power)			
(7) electric log <u>no</u> (yes or no) (organization running log)			
(8) how well bottom plugged <u>back wash valve</u>			
DRILLERS REMARKS:			

DEPT. OF NATURAL RESOURCES
 BUREAU OF LAND & WATER RESOURCES

JUN 11 1984
RECEIVED

If well telescopes please sketch and show depths.

GROUND LEVEL

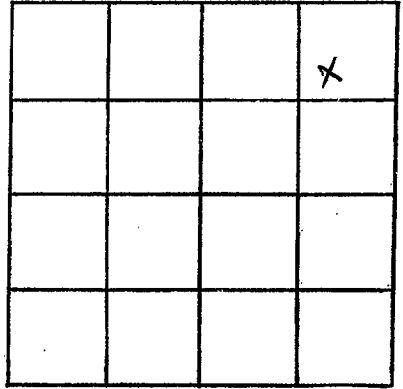

SECTION /

Please indicate well location X.

ADDITIONAL INFORMATION

If more than one screen,
show locations of each on sketch.