

MISSISSIPPI DEPARTMENT OF NATURAL RESOURCES

Bureau of Land and Water Resources

Southport Mall

P.O. Box 10631

Jackson, Mississippi 39209

WATER WELL DRILLERS LOG

<i>Lincoln</i>
<i>L</i>
<i>2057</i>

Jan 11 19*84*
date well completed

News Well Ser.
firm name

Lincoln
county well located

LANDOWNER:	description of formations encountered	from	to
<i>Woodie Franklin</i> <i>Rt Brookhaven</i> (mailing address)			
WELL LOCATION:			
sec. <i>6</i> T- <i>6</i> N R- <i>7</i> E			
<i>5 1/2</i> miles <i>W SW</i> of <i>Brookhaven</i> (distance) (direction) (nearest town)			
WELL PURPOSE: <i>house</i> (home, irrigation, municipal, industrial)			
WELL COMPLETION DATA:			
(1) diameter (inches) <i>4"</i>			
(2) total depth (feet) <i>74'</i>			
(3) static water level (feet) <i>60'</i> below above top of ground.			
(4) casing <i>plastic, bottom</i> (material) (depth)			
<i>7</i> (size) if telescope see back.			
(5) screen <i>6'</i> <i>78'</i> (length) (depth to top)			
<i>4"</i> <i>plastic</i> (size) (material)			
(6) pump <i>1/2</i> <i>10</i> (HP) (yield gpm)			
<i>split</i> (type power)			
(7) electric log <i>no</i> (yes or no)			
(organization running log)			
(8) how well bottom plugged <i>back wash</i>			
DRILLERS REMARKS:			


MISSISSIPPI DEPARTMENT OF NATURAL RESOURCES
BUREAU OF LAND & WATER RESOURCES

JUN 11 1984

RECEIVED

If well telescopes please sketch and show depths.

GROUND LEVEL

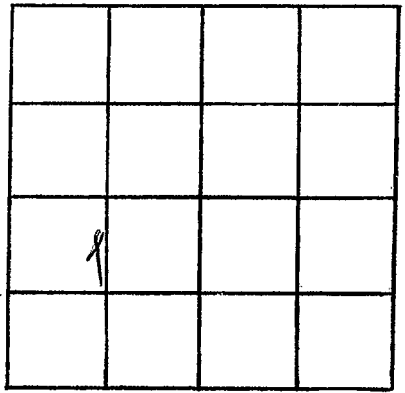

SECTION 6

Please indicate well location X.

ADDITIONAL INFORMATION

Lined area for additional information.

If more than one screen, show locations of each on sketch.