

MISSISSIPPI DEPARTMENT OF NATURAL RESOURCES

Bureau of Land and Water Resources

Southport Mall

P.O. Box 10631

Jackson, Mississippi 39209

WATER WELL DRILLERS LOG

Lincoln  
L 2058

4-13 1984 Fitzgerald Well Co Lincoln  
date well completed firm name county well located


LANDOWNER:	description of formations encountered	from	to
<u>Feed London</u>			
<u>RR. McCall Co. MS.</u> (mailing address)	<u>Red clay</u>	<u>0</u>	<u>20</u>
	<u>Red granite</u>	<u>20</u>	<u>80</u>
	<u>Blue chalk</u>	<u>80</u>	<u>205</u>
	<u>Coarse sandstone</u>	<u>205</u>	<u>220</u>
<b>WELL LOCATION:</b>			
sec. <u>6</u> T. <u>6</u> N. R. <u>7</u> E S W			
<u>12</u> miles <u>W</u> of <u>Brookhaven</u> (distance) (direction) (nearest town)			
<b>WELL PURPOSE:</b> (home, irrigation, municipal, industrial)			
<u>Home</u>			
<b>WELL COMPLETION DATA:</b>			
(1) diameter (inches) <u>4</u>			
(2) total depth (feet) <u>220</u>			
(3) static water level (feet) <u>135</u> below top of ground.			
(4) casing <u>PVC</u> , <u>212</u> , (material) (depth), <u>4</u> if telescope see back. (size)			
(5) screen <u>8</u> , <u>212</u> (length) (depth to top) <u>4</u> (size), <u>PVC</u> (material)			
(6) pump <u>1/2</u> , <u>10</u> (HP) (yield gpm) <u>Electric</u> (type power)			
(7) electric log <u>Yes</u> (yes or no) (organization running log)			
(8) how well bottom plugged <u>Sand</u>			
<b>DRILLERS REMARKS:</b>			

DEPT. OF NATURAL RESOURCES  
BUREAU OF LAND & WATER RESOURCES

APR 26 1984  
RECEIVED

If well telescopes please sketch and show depths.

GROUND LEVEL

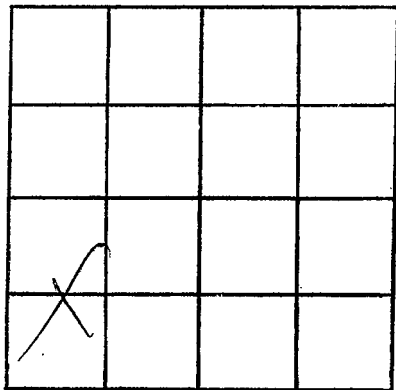

SECTION 6

Please indicate well location X.

ADDITIONAL INFORMATION

If more than one screen,  
show locations of each on sketch.