

LINCOLN
L 2059

MISSISSIPPI DEPARTMENT OF NATURAL RESOURCES
Bureau of Land and Water Resources
Southport Mall
P.O. Box 10631
Jackson, Mississippi 39209
WATER WELL DRILLERS LOG

May 7 1984 Grenn Water Well Lincoln
date well completed firm name county well located

LANDOWNER: Versie Hall	description of formations encountered	from	to
Rt. 4, Box 221A			
Bogue Chitto, Ms.	sand & gravel	20	46
(mailing address)	white clay	46	75
	sand	75	130
WELL LOCATION:			
sec 19 T 6 N R 7 E S W			
4 miles NW of Bogue Chitto (distance) (direction) (nearest town)			
WELL PURPOSE: home (home, irrigation, municipal, industrial)			
WELL COMPLETION DATA:			
(1) diameter (inches) 4			
(2) total depth (feet) 130			
(3) static water level (feet) 46 below above top of ground.			
(4) casing PVC 120' (material) (depth) 4" If telescope see back. (size)			
(5) screen 10' 120' (length) (depth to top) .010 PVC (size) (material)			
(6) pump 1/2 sub 8 (HP) (yield gpm) electricity (type power)			
(7) electric log no (yes or no) (organization running log)			
(8) how well bottom plugged back wash valve			
DRILLERS REMARKS:			


DEPT. OF NATURAL RESOURCES
BUREAU OF LAND & WATER RESOURCES

JUL 24 1984

RECEIVED

If well telescopes please sketch and show depths.

GROUND LEVEL

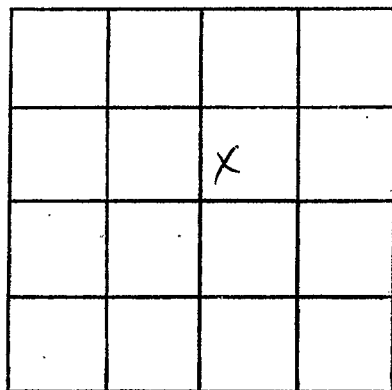

SECTION 19

Please indicate well location X.

ADDITIONAL INFORMATION

If more than one screen,
show locations of each on sketch.