

MISSISSIPPI DEPARTMENT OF NATURAL RESOURCES

Bureau of Land and Water Resources

Southport Mall

P.O. Box 10631

Jackson, Mississippi 39209

WATER WELL DRILLERS LOG

Lincoln
L
2060

July 23 1984 Grenn Water Well Lincoln
 date well completed firm name county well located

LANDOWNER: Sheila Laird

description of formations encountered from to
 Citronelle 1 95

306 Albert St.

Brookhaven, Ms.
 (mailing address)

WELL LOCATION:

sec. 11 T 6 N R 7 E
 S W

4 miles S of Brookhaven
 (distance) (direction) (nearest town)

WELL PURPOSE: home
 (home, irrigation, municipal, industrial)

WELL COMPLETION DATA:

- (1) diameter (inches) 4
 (2) total depth (feet) 95
 (3) static water level (feet) 60 below above top of ground.
 (4) casing PVC 75'
 (material) (depth),
 4" If telescope see back.
 (size)
 (5) screen 20' 75'
 (length) (depth to top)
 .010 PVC
 (size) (material)
 (6) pump 1/2 sub 8
 (HP) (yield gpm)
 electricity
 (type power)
 (7) electric log no
 (yes or no)
 (organization running log)

(8) how well bottom plugged back wash valve


DRILLERS REMARKS:

MISSISSIPPI DEPARTMENT OF NATURAL RESOURCES
 BUREAU OF LAND & WATER RESOURCES
 JACKSON, MISSISSIPPI

SEP 18 1984
 RECEIVED

If well telescopes please sketch and show depths.

GROUND LEVEL

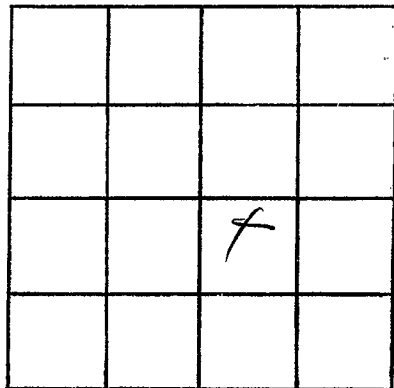

SECTION 11

Please indicate well location X.

ADDITIONAL INFORMATION

If more than one screen,
show locations of each on sketch.