

Lincoln
 L
 2062

MISSISSIPPI DEPARTMENT OF NATURAL RESOURCES
 Bureau of Land and Water Resources
 Southport Mall
 P.O. Box 10631
 Jackson, Mississippi 39209
WATER WELL DRILLERS LOG

10-15

84 Grenn Water Well

Lincoln

date well completed

firm name

county well located

LANDOWNER: John Paul Smith

Rt. 5, Box 917B

Brookhaven, Ms.

(mailing address)

WELL LOCATION:

sec. 6 T. 6 N. R. 7 E.
 S. W.

5 miles SW of Brookhaven
 (distance) (direction) (nearest town)

WELL PURPOSE: Home

(home, irrigation, municipal, industrial)

WELL COMPLETION DATA:

- (1) diameter (inches) 4
- (2) total depth (feet) 217
- (3) static water level (feet) 91 below
 top of ground.
- (4) casing PVC, 207'
 (material) (depth)
4"
 (size) if telescope see back.
- (5) screen 10', 207'
 (length) (depth to top)
.010, PVC
 (size) (material)
- (6) pump 3/4 sub 8
 (HP) (yield gpm)
electricity
 (type power)
- (7) electric log no
 (yes or no)

(organization running log)

(8) how well bottom plugged back wash valve

DRILLERS REMARKS:

description of formations
 encountered

from

to

Clay	1	20
Sand & Gravel	20	80
White clay	80	100
Blue Clay	100	140
White clay	140	170
Sand	170	217


DEPT. OF NATURAL RESOURCES
 BUREAU OF LAND & WATER RESOURCES

NOV 15 1984

RECEIVED

If well telescopes please sketch and show depths.

GROUND LEVEL

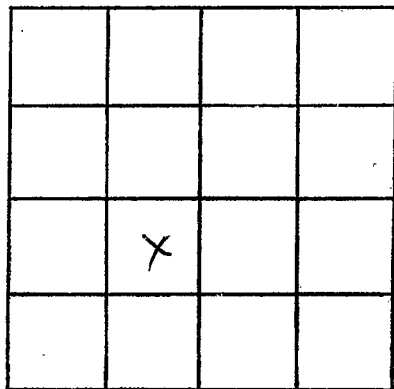

SECTION 6

Please indicate well location X.

ADDITIONAL INFORMATION

If more than one screen,
show locations of each on sketch.