

MISSISSIPPI DEPARTMENT OF NATURAL RESOURCES

Bureau of Land and Water Resources

Southport Mall

P.O. Box 10631

Jackson, Mississippi 39209

WATER WELL DRILLERS LOG

Lincoln
L 2063
1-9-85

Jan 9 1985 Renue Well Serv Lincoln
date well completed firm name county well located

LANDOWNER:
Albert Zachary
PO Boone Chitto
(mailing address)

description of formations encountered	from	to
<u>Red sandy Clay</u>	<u>0</u>	<u>16</u>
<u>sand gravel</u>	<u>16</u>	<u>45</u>
<u>gravel</u>	<u>45</u>	<u>52</u>
<u>blue clay</u>	<u>52</u>	<u>150</u>
<u>cross sand</u>	<u>150</u>	<u>173</u>

WELL LOCATION:
sec. 12 T. 6 N R. 7 E
4 miles South of Brookman
(distance) (direction) (nearest town)

WELL PURPOSE: Home
(home, irrigation, municipal, industrial)

WELL COMPLETION DATA:

(1) diameter (inches) 4"

(2) total depth (feet) 173

(3) static water level (feet) 58 below above top of ground.

(4) casing plastic bottom
(material) (depth)

 if telescope see back.
(size)

(5) screen 5' 168"
(length) (depth to top)

4" plastic
(size) (material)

(6) pump 1/2 10
(HP) (yield gpm)


heat
(type power)

(7) electric log no
(yes or no)

(organization running log)

(8) how well bottom plugged back wash

DRILLERS REMARKS:

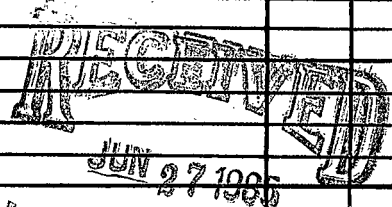

Department of Natural Resources
Bureau of Land & Water Resources

If well telescopes please sketch and show depths.

GROUND LEVEL

X			

SECTION 12

Please indicate well location X.

ADDITIONAL INFORMATION

If more than one screen,
show locations of each on sketch.