

MISSISSIPPI DEPARTMENT OF NATURAL RESOURCES

Bureau of Land and Water Resources

Southport Mall

P.O. Box 10631

Jackson, Mississippi 39209

WATER WELL DRILLERS LOG

Lincoln
L 2064

Oct. 1 1985

Gretn Water Well

Lincoln

date well completed

firm name

county well located

LANDOWNER: Tommy Davis	description of formations encountered	from	to
Rt. 2, Box 43A			
Bogue Chitto, Ms. (mailing address)			
WELL LOCATION: sec. 22 T 6 N R 7 E S W 3 miles NW of Bogue Chitto (distance) (direction) (nearest town)			
WELL PURPOSE: home (home, irrigation, municipal, industrial)			
WELL COMPLETION DATA: 4			
(1) diameter (inches)			
(2) total depth (feet) 123			
(3) static water level (feet) 63 below top of ground.			
(4) casing PVC, 113' (material) (depth) 4" (size) If telescope see back.			
(5) screen 10', 113' (length) (depth to top) .010 PVC (size) (material)			
(6) pump 1/2 sub 8 (HP) (yield gpm) electricity (type power)			
(7) electric log no (yes or no) (organization running log)			
(8) how well bottom plugged back wash valve			


RECEIVED
NOV - 4 1985

Department of Natural Resources
Bureau of Land & Water Resources

DRILLERS REMARKS:

If well telescopes please sketch and show depths.

GROUND LEVEL

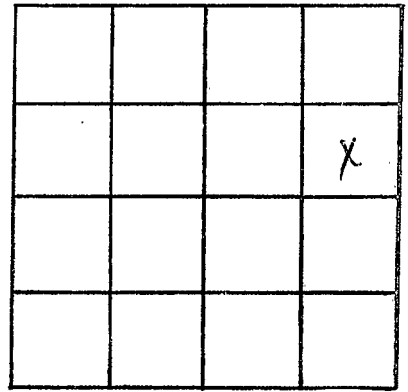

SECTION 22

Please indicate well location X.

ADDITIONAL INFORMATION

If more than one screen,
show locations of each on sketch.