

MISSISSIPPI DEPARTMENT OF NATURAL RESOURCES
Bureau of Land and Water Resources
 Southport Mall
 P.O. Box 10631
 Jackson, Mississippi 39209
WATER WELL DRILLERS LOG

Lincoln
L7065

1-13-86 19 Gretn Water Well Lincoln
 date well completed firm name county well located


LANDOWNER: <u>Charles Gaston</u> Rt. 4, Box 123	description of formations encountered <u>Citronelle</u>	from <u>1</u>	to <u>77</u>
<u>Bogue Chitto, Ms.</u> (mailing address)			
WELL LOCATION: sec. <u>2</u> T. <u>6</u> N. R. <u>7</u> E S. W. <u>4</u> miles <u>South</u> of <u>Brookhaven</u> (distance) (direction) (nearest town)			
WELL PURPOSE: <u>home</u> (home, irrigation, municipal, industrial)			
WELL COMPLETION DATA: (1) diameter (inches) <u>4</u> (2) total depth (feet) <u>77</u> (3) static water level (feet) <u>55</u> below above top of ground. (4) casing <u>PVC</u> <u>67</u> (material) (depth) <u>4"</u> if telescope see back. (size) (5) screen <u>10'</u> <u>67'</u> (length) (depth to top) <u>.010</u> <u>PVC</u> (size) (material) (6) pump <u>1/2</u> sub <u>10</u> (HP) (yield gpm) <u>electricity</u> (type power) (7) electric log <u>no</u> (yes or no) <u>(organization running log)</u> (8) how well bottom plugged <u>back wash valve</u>			

RECEIVED
 FEB 20 1986

DRILLERS REMARKS:
 Department of Natural Resources
 Bureau of Land & Water Resources

If well telescopes please
sketch and show depths.

GROUND LEVEL

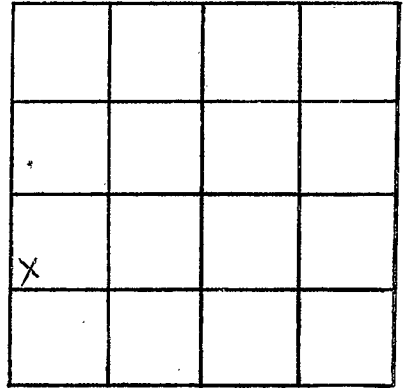

SECTION 2

Please indicate well location X.

ADDITIONAL INFORMATION

If more than one screen,
show locations of each on sketch.