

MISSISSIPPI DEPARTMENT OF NATURAL RESOURCES

Bureau of Land and Water Resources

Southport Mall

P.O. Box 10631


Jackson, Mississippi 39209

WATER WELL DRILLERS LOG

LINCOLN
L 2067

2-27 1986 Grenn Water Well Lincoln
 date well completed firm name county well located


LANDOWNER:	Description of formations encountered	from	to
Houston McCaffery Rt. 4, Bogue Chitto, Ms. (mailing address)	Citronelle	1	1067
WELL LOCATION: sec. <u>28</u> <u>6</u> N <u>7</u> E S W <u>3</u> miles <u>NW</u> of <u>Bogue Chitto</u> (distance) (direction) (nearest town)			
WELL PURPOSE: <u>home</u> (home, irrigation, municipal, industrial)			
WELL COMPLETION DATA:			
(1) diameter (inches) <u>4</u>			
(2) total depth (feet) <u>106</u>			
(3) static water level (feet) <u>56</u> below top of ground. above			
(4) casing <u>PVC</u> <u>96</u> (material) (depth) <u>4"</u> (size) if telescope see back.			
(5) screen <u>10'</u> <u>96'</u> (length) (depth to top) <u>.010</u> <u>PVC</u> (size) (material)			
(6) pump <u>1/2</u> sub <u>7</u> (HP) (yield gpm) electricity (type power)			
(7) electric log <u>no</u> (yes or no) (organization running log)			
(8) how well bottom plugged <u>back wash valve</u>			
DRILLERS REMARKS:			

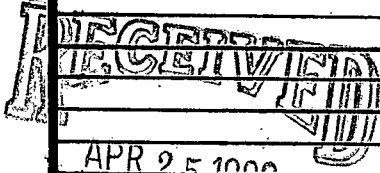

Department of Natural Resources
 Land & Water Resources

If well telescopes please sketch and show depths.

GROUND LEVEL

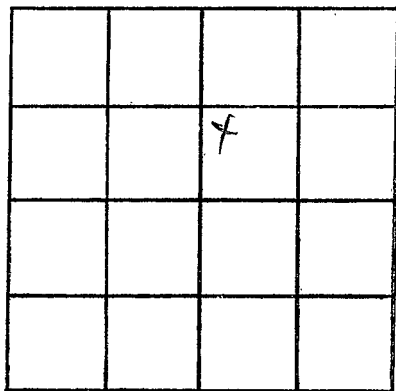

SECTION 28

Please indicate well location X.

ADDITIONAL INFORMATION

If more than one screen,
show locations of each on sketch.