

MISSISSIPPI DEPARTMENT OF NATURAL RESOURCES

Bureau of Land and Water Resources

Southport Mall

P.O. Box 10631

Jackson, Mississippi 39209

WATER WELL DRILLERS LOG

LINCOLN
L 2068

4-4-86 19 Gretn Water Well Lincoln
 date well completed firm name county well located

LANDOWNER: Gayle Evans
P.O. Box 55
McCall Creek, Ms.
 (mailing address)

description of formations encountered	from	to
	<u>Citronelle</u>	<u>1</u>


WELL LOCATION:
 sec. 7 T. N R. 7 E
 S W
6 miles SW of Brookhaven
 (distance) (direction) (nearest town)

WELL PURPOSE: home
 (home, irrigation, municipal, industrial)

WELL COMPLETION DATA:
 (1) diameter (inches) 4
 (2) total depth (feet) 95
 (3) static water level (feet) 55 below above
 top of ground.
 (4) casing PVC 85'
 (material) (depth)
 4"
 (size) if telescope see back.
 (5) screen 10' 85'
 (length) (depth to top)
 .010 PVC
 (size) (material)
 (6) pump 3/4 sub 10
 (HP) (yield gpm)
electricity
 (type power)
 (7) electric log no
 (yes or no)

 (organization running log)
 (8) how well bottom plugged
BACK wash valve


DRILLERS REMARKS:

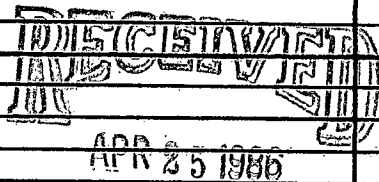

Department of Natural Resources
 Bureau of Land & Water Resources

If well telescopes please sketch and show depths.

GROUND LEVEL

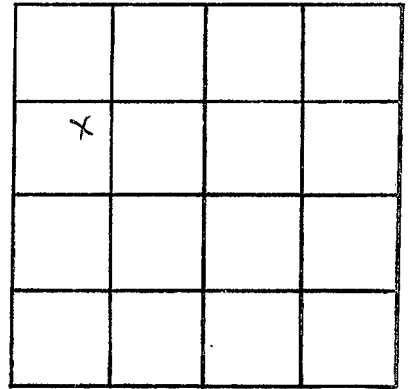

SECTION 7

Please indicate well location X.

ADDITIONAL INFORMATION

If more than one screen,
show locations of each on sketch.