

LINCOLN
L
2069

MISSISSIPPI DEPARTMENT OF NATURAL RESOURCES
Bureau of Land and Water Resources
Southport Mall
P.O. Box 10631
Jackson, Mississippi 39209
WATER WELL DRILLERS LOG

4-9-86 date well completed Fitzgerald Well Serv firm name LINCOLN county well located

LANDOWNER: A. Pike
RR - Bogrechitto, ms.
(mailing address)

description of formations encountered	from	to
<u>Red clay</u>	<u>0</u>	<u>20</u>
<u>Red sand</u>	<u>20</u>	<u>90</u>
<u>Coarse sandstone</u>	<u>90</u>	<u>121</u>

WELL LOCATION:
sec 32 T 6 N R 7 E
S W
6 miles W of Bogrechitto
(distance) (direction) (nearest town)

WELL PURPOSE: Home
(home, irrigation, municipal, industrial)


- WELL COMPLETION DATA:
- (1) diameter (inches) 4
 - (2) total depth (feet) 121
 - (3) static water level (feet) 65 below above top of ground.
 - (4) casing PVC 1 1/2 (material), (depth)
4 (size) if telescope see back.
 - (5) screen 10 (length), 1 1/2 (depth to top)
4 (size), PVC (material)
 - (6) pump 1/2 (HP), 10 (yield gpm)
elec (type power)
 - (7) electric log no (yes or no)
(organization running log)
 - (8) how well bottom plugged Seal off

DRILLERS REMARKS: _____

RECEIVED
MAY - 5 1986

If well telescopes please sketch and show depths.

GROUND LEVEL

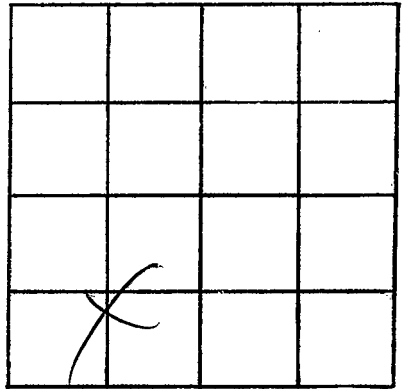

SECTION 32

Please indicate well location X.

ADDITIONAL INFORMATION

If more than one screen,
show locations of each on sketch.