

MISSISSIPPI DEPARTMENT OF NATURAL RESOURCES
 Bureau of Land and Water Resources
 Southport Mall
 P.O. Box 10631
 Jackson, Mississippi 39209
WATER WELL DRILLERS LOG

LINCOLN
 L
 2070

Feb 11 1986 Rever well ser Lincoln
 date well completed firm name county well located


LANDOWNER:
Gary Karmunoff
(unknown) (med forest)
 (mailing address)

description of formations encountered	from	to
<u>sandy clay</u>	<u>0</u>	<u>27</u>
<u>Red shale</u>	<u>27</u>	<u>80</u>
<u>White & blue clay</u>	<u>80</u>	<u>160</u>
<u>sand</u>	<u>160</u>	<u>185</u>

WELL LOCATION:
 sec 6 T 6 N R 7 E
6 miles West of Broadway
 (distance) (direction) (nearest town)

WELL PURPOSE: Private
 (home, irrigation, municipal, industrial)

- WELL COMPLETION DATA:**
- diameter (inches) 4"
 - total depth (feet) 185
 - static water level (feet) 78' below top of ground.
 - casing plastic (material) bottom (depth)
 (size) if telescope see back.
 - screen 5" (length) 180 (depth to top)
4" (size) plastic (material)
 - pump 3/4" Dale (HP) 10 (yield gpm)
sheet (type power)
 - electric log no (yes or no)
 (organization running log)
 - how well bottom plugged backstop

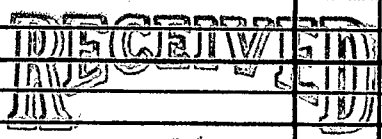


JUL 01 1986

Department of Natural Resources
 Bureau of Land & Water Resources

DRILLERS REMARKS:

If well telescopes please sketch and show depths.

GROUND LEVEL

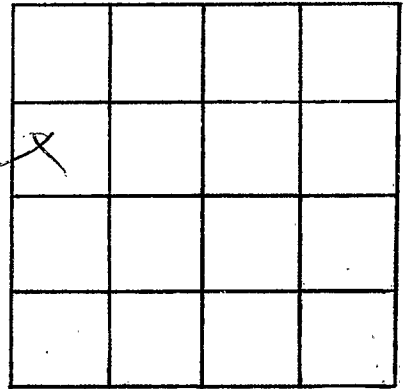

SECTION 6

Please indicate well location X.

ADDITIONAL INFORMATION

If more than one screen,
show locations of each on sketch.