

LINCOLN
L
2071

MISSISSIPPI DEPARTMENT OF NATURAL RESOURCES
Bureau of Land and Water Resources
Southport Mall
P.O. Box 10631
Jackson, Mississippi 39209
WATER WELL DRILLERS LOG

7-25 1986 Fitzgerald Well Serv Lincoln
date well completed firm name county well located

LANDOWNER:	description of formations encountered	from	to
Sherrill Stringer P.R. Brophy, Mrs. (mailing address)			
WELL LOCATION:			
sec. <u>6</u> T <u>6</u> N R <u>7</u> E S W			
<u>2</u> miles <u>E</u> of <u>West Lincoln</u> (distance) (direction) (nearest town)			
WELL PURPOSE: <u>Home</u> (home, irrigation, municipal, industrial)			
WELL COMPLETION DATA:			
(1) diameter (inches) <u>4</u>			
(2) total depth (feet) <u>206</u>			
(3) static water level (feet) <u>93</u> below top of ground. above			
(4) casing <u>PVC</u> , <u>196</u> , (material) (depth) <u>4</u> (size) if telescope see back.			
(5) screen <u>10</u> , <u>196</u> (length) (depth to top) <u>4</u> , <u>PVC</u> (size) (material)			
(6) pump <u>1/2</u> , <u>10</u> (HP) (yield gpm) <u>Electric</u> (type power)			
(7) electric log <u>no</u> (yes or no) <u>(organization running log)</u>			
(8) how well bottom plugged <u>Sand block</u>			


RECEIVED
AUG 13 1986

Department of Natural Resources
Bureau of Land & Water Resources

DRILLERS REMARKS:

If well telescopes please sketch and show depths.

GROUND LEVEL

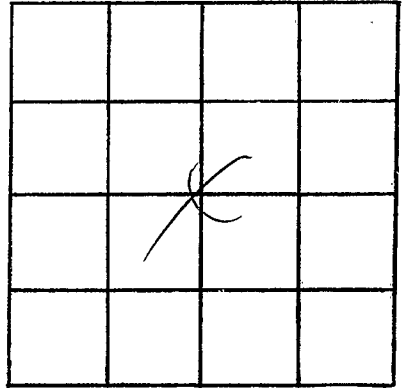

SECTION 6

Please indicate well location X.

ADDITIONAL INFORMATION

If more than one screen,
show locations of each on sketch.