

MISSISSIPPI DEPARTMENT OF NATURAL RESOURCES

Bureau of Land and Water Resources

Southport Mall

P.O. Box 10631

Jackson, Mississippi 39209

WATER WELL DRILLERS LOG

LINCOLN
L 2072

10/1 1986 Easley Plumbing Co @ *Burns District* Lincoln
date well completed firm name county well located

LANDOWNER: <i>Ricky McGuffie</i>	description of formations encountered	from	to
<i>RT2 Box 95R</i>	<i>Clay</i>	<i>0</i>	<i>60</i>
<i>Boguechitto, MS. 39629</i>	<i>Sand</i>	<i>60</i>	<i>68</i>
<i>(mailing address)</i>	<i>clay</i>	<i>68</i>	<i>210</i>
	<i>Sand</i>	<i>210</i>	<i>220</i>
WELL LOCATION:			
sec. <i>1</i> T <i>B</i> N R <i>8</i> E			
<i>3</i> miles <i>S</i> of <i>B'Haven</i>			
(distance) (direction) (nearest town)			
WELL PURPOSE: <i>Home</i>			
(home, irrigation, municipal, industrial)			
WELL COMPLETION DATA:			
(1) diameter (inches) <i>4"</i>			
(2) total depth (feet) <i>220'</i>			
(3) static water level (feet) <i>84'</i> below above top of ground.			
(4) casing <i>PVC</i> , <i>210'</i> (material) (depth)			
<i>4"</i> (size) if telescope see back.			
(5) screen <i>10'</i> , <i>210'</i> (length) (depth to top)			
<i>4"</i> (size) <i>PVC</i> (material)			
(6) pump <i>1</i> (HP) <i>10</i> (yield gpm)			
<i>electricity</i> (type power)			
(7) electric log <i>No</i> (yes or no)			
(organization running log)			
(8) how well bottom plugged <i>Backwash Valve</i>			
DRILLERS REMARKS:			


REGISTERED

DEC 24 1986

Department of Natural Resources
Bureau of Land & Water Resources

If well telescopes please sketch and show depths.

GROUND LEVEL

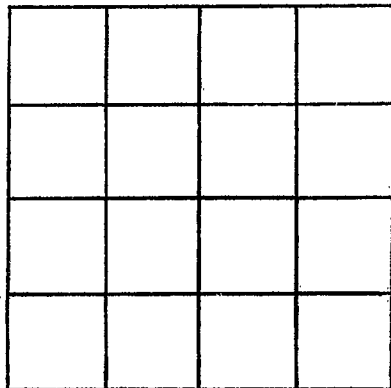

SECTION _____

Please indicate well location X.

ADDITIONAL INFORMATION

If more than one screen,
show locations of each on sketch.