

MISSISSIPPI DEPARTMENT OF NATURAL RESOURCES
Bureau of Land and Water Resources

P.O. Box 10631

Jackson, Mississippi 39209

WATER WELL DRILLERS LOG

COUNTY WELL LOCATED <i>Lincoln</i>	
WELL NUMBER <i>L 2093</i>	CODED
DATE WELL COMPLETED <i>10-18-88</i>	

PERMIT NUMBER
NAME OF DRILLING FIRM <i>Home water wells</i>
<i>Supply, Inc.</i>

NAME & MAILING ADDRESS OF LANDOWNER <i>J.D. Johnson Jr.</i>			
<i>Rt 1 Box 177</i>			
<i>Zornthello, Mrs.</i>			
WELL LOCATION:	SEC	TOWNSHIP	RANGE
	<i>2</i>	<i>6</i>	<i>N 7 E</i>
DISTANCE	DIRECTION	NEAREST TOWN	
<i>4</i> Miles	<i>S</i>	<i>Broadhaven</i>	
OTHER LANDMARK			
WELL PURPOSE <u>Home</u> Irrigation, Municipal, Industrial, Fish Pond, etc.			

PUMP DATA		
PUMP TYPE (Circle One): Submersible, Turbine, Jet, Flowing Well, Other (Describe) <u>did not install</u>		
POWER TYPE (Circle One): Electric, Tractor, Diesel, Gasoline, Butane, Other (Describe) <u>H/P</u>		
Pump Capacity (GPM)	No. of Stages	Setting Depth
		FT.
PUMP TEST		
Well yielded <u>14</u> GPM with a drawdown of <u>0</u> ft. after <u>2</u> hours of pumping		

WELL DATA		
Well Depth <i>188</i>	Casing Diameter (In.) <i>4</i>	Casing Length (Ft.) <i>178</i>
Type of Casing <i>PVC</i>	Hole Depth <i>200</i>	Depth to Static Water Level <i>40</i>
TYPE OF COMPLETION: (Circle One or More): <input checked="" type="checkbox"/> Gravel Packed, <input type="checkbox"/> Underreamed, <input type="checkbox"/> Telescoped, <input type="checkbox"/> Natural Development, <input type="checkbox"/> Open Hole, <input type="checkbox"/> Other (Describe)		
Top of Lap Pipe or Reduction in Casing		
FEET	IF TELESCOPED OR MORE THAN ONE SCREEN: USE BACK PAGE	

LOG DATA	
TYPE OF LOG RUN (Circle One): Electric, Gamma Ray, Density, Sonic, Neutron, Other (Describe) <u>No Log Run</u>	
Name of Organization Running Log	

SCREEN DATA		
Diameter - Inches <i>4</i>	Length - Feet <i>10</i>	Slot Size - Inches <i>.010</i>
Screen Type <i>PVC</i>	Depth to Bottom - Feet <i>188</i>	

GEOLOGIC DATA (Office Use Only)			
Surface Elev.	Geologic Unit	Unit Thickness	Depth to Top
Subs. SWL	Date	Analysis	Aquifer Test


Driller's Remarks

DESCRIPTION OF FORMATIONS ENCOUNTERED	FROM	TO	FORMATIONS (Continued)	FROM	TO
<i>Cretaceous</i>	<i>0</i>	<i>30</i>	RECEIVED FEB 9 1989 Department of Natural Resources Bureau of Land & Water Resources		
<i>Clay</i>	<i>30</i>	<i>160</i>			
<i>Sand</i>	<i>160</i>	<i>200</i>			

IF MORE SPACE IS NEEDED, USE BACK

If well telescopes please sketch and show depths.

GROUND LEVEL

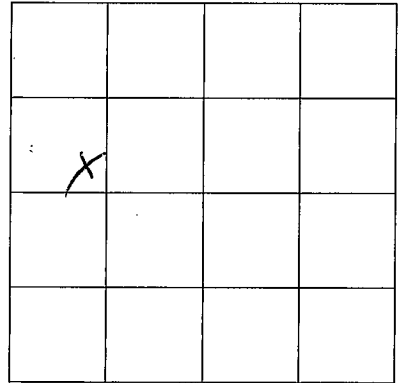

SECTION 2

Please indicate well location X.

ADDITIONAL INFORMATION

Lined area for providing additional information.

If more than one screen,
show location of each on sketch.