

MISSISSIPPI DEPARTMENT OF NATURAL RESOURCES

Bureau of Land and Water Resources

P.O. Box 10631

Jackson, Mississippi 39209

WATER WELL DRILLERS LOG

COUNTY WELL LOCATED LINCOLN	
WELL NUMBER L 2113	CODED
DATE WELL COMPLETED 6-2-90	

PERMIT NUMBER
NAME OF DRILLING FIRM Easley Water Well
Bladen ms 39601

NAME & MAILING ADDRESS OF LANDOWNER WARREN Smith		
Brookhaven, ms. 39601		
WELL LOCATION: SEC	TOWNSHIP	RANGE
Lincoln 20	6	7
DISTANCE	DIRECTION	NEAREST TOWN
6 Miles	South of	Brookhaven
OTHER LANDMARK		
WELL PURPOSE: Home, Irrigation, Municipal, Industrial, Fish Pond, etc. Home		

PUMP DATA		
PUMP TYPE (Circle One): <input checked="" type="radio"/> Submersible, <input type="radio"/> Turbine, <input type="radio"/> Jet <input type="radio"/> Flowing Well, Other (Describe) _____		
POWER TYPE (Circle One): Electric, <input type="radio"/> Tractor, <input type="radio"/> Diesel, <input type="radio"/> Gasoline, <input type="radio"/> Butane, Other (Describe) 1/2 HP		
Pump Capacity (GPM)	No. of Stages	Setting Depth
10	9	40 FT.
PUMP TEST		
Well yielded _____ GPM with a drawdown of _____ ft. after _____ hours of pumping		

WELL DATA		
Well Depth A 50	Casing Diameter (In.) 4"	Casing Length (Ft.) 30'
Type of Casing PUC40	Hole Depth 50'	Depth to Static Water Level
TYPE OF COMPLETION: (Circle One or More): <input checked="" type="radio"/> Gravel Packed, <input type="radio"/> Underreamed, <input type="radio"/> Telescoped, <input checked="" type="radio"/> Natural Development, <input type="radio"/> Open Hole, <input type="radio"/> Other (Describe) _____		
Top of Lap Pipe or Reduction in Casing		
FEET	IF TELESCOPED OR MORE THAN ONE SCREEN: USE BACK PAGE	

LOG DATA	
TYPE OF LOG RUN (Circle One): <input checked="" type="radio"/> No Log Run, <input type="radio"/> Electric, <input type="radio"/> Gamma Ray, <input type="radio"/> Density, <input type="radio"/> Sonic, <input type="radio"/> Neutron, Other (Describe) _____	
Name of Organization Running Log	

SCREEN DATA		
Diameter - Inches 4"	Length - Feet 20'	Slot Size - Inches 0/0
Screen Type PUC	Depth to Bottom - Feet 50'	

GEOLOGIC DATA (Office Use Only)			
Surface Elev.	Geologic Unit	Unit Thickness	Depth to Top
Subs. SWL	Date	Analysis	Aquifer Test

Driller's Remarks


RECEIVED

DESCRIPTION OF FORMATIONS ENCOUNTERED	FROM	TO	FORMATIONS (Continued)	FROM	TO
clay	0ft.	10ft.	<div style="font-size: 2em; font-weight: bold; margin-bottom: 10px;">JUN 7 1991</div> <div style="font-size: 1.2em; font-weight: bold;">Dept. of Environmental Quality Bureau of Land & Water Resources</div>		
fine sand	10ft.	30ft.			
coarse sand	30ft.	40ft.			
clay	40ft.	50ft.			

IF MORE SPACE IS NEEDED, USE BACK

If well telescopes please sketch and show depths.

GROUND LEVEL

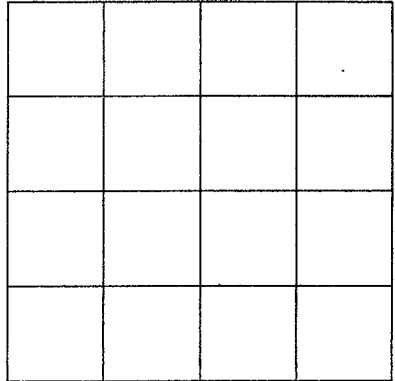

SECTION _____

Please indicate well location X.

ADDITIONAL INFORMATION

Lined area for additional information.

If more than one screen, show location of each on sketch.