

MISSISSIPPI DEPARTMENT OF NATURAL RESOURCES

Bureau of Land and Water Resources

P.O. Box 10631

Jackson, Mississippi 39209

WATER WELL DRILLERS LOG

COUNTY WELL LOCATED LINCOLN	
WELL NUMBER 379043	CODED
L 217	
DATE WELL COMPLETED 8-19-91	

PERMIT NUMBER 510
NAME OF DRILLING FIRM Easley Water Well
Brookhaven, MS 39601

NAME & MAILING ADDRESS OF LANDOWNER Larry Case			
WELL LOCATION: SEC	TOWNSHIP	RANGE	
7	6	N S R7 E W	
DISTANCE	DIRECTION	NEAREST TOWN	
3 Miles	SW	of _____	
OTHER LANDMARK New Prospect Church			
WELL PURPOSE: <input checked="" type="checkbox"/> Home Irrigation, <input type="checkbox"/> Municipal, <input type="checkbox"/> Industrial, <input type="checkbox"/> Fish Pond, etc.			

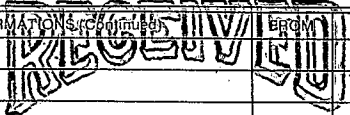
PUMP DATA		
PUMP TYPE (Circle One): <input checked="" type="checkbox"/> Submersible, <input type="checkbox"/> Turbine, <input type="checkbox"/> Jet <input type="checkbox"/> Flowing Well, Other (Describe) NONE		
POWER TYPE (Circle One): <input type="checkbox"/> Electric, <input type="checkbox"/> Tractor, <input type="checkbox"/> Diesel, <input type="checkbox"/> Gasoline, <input type="checkbox"/> Butane, Other (Describe) _____		
Pump Capacity (GPM)	No. of Stages	Setting Depth FT.
PUMP TEST		
Well yielded _____ GPM with a drawdown of _____ ft. after _____ hours of pumping		

WELL DATA		
Well Depth 80'	Casing Diameter (In.) 4"	Casing Length (Ft.) 60'
Type of Casing PVC	Hole Depth 80'	Depth to Static Water Level
TYPE OF COMPLETION: (Circle One or More): <input checked="" type="checkbox"/> Gravel Packed, <input type="checkbox"/> Underreamed, <input type="checkbox"/> Telescoped, <input checked="" type="checkbox"/> Natural Development, <input type="checkbox"/> Open Hole, <input type="checkbox"/> Other		
Top of Lap Pipe or Reduction in Casing FEET IF TELESCOPED OR MORE THAN ONE SCREEN: USE BACK PAGE		

LOG DATA	
TYPE OF LOG RUN (Circle One): <input checked="" type="checkbox"/> No Log Run, <input type="checkbox"/> Electric, <input type="checkbox"/> Gamma Ray, <input type="checkbox"/> Density, <input type="checkbox"/> Sonic, <input type="checkbox"/> Neutron, Other (Describe) _____	
Name of Organization Running Log	

SCREEN DATA		
Diameter - Inches 4"	Length - Feet 20'	Slot Size - Inches 010
Screen Type PVC	Depth to Bottom - Feet 80'	

GEOLOGIC DATA (Office Use Only)			
Surface Elev.	Geologic Unit	Unit Thickness	Depth to Top
Subs. SWL	Date	Analysis	Aquifer Test
Driller's Remarks			

DESCRIPTION OF FORMATIONS ENCOUNTERED	FROM	TO	FORMATIONS ENCOUNTERED FROM TO
Clay	0	10'	<div style="text-align: center;">  JUN 26 1992 Dept. of Environmental Quality Bureau of Land & Water Resources </div>
FINE SAND	10'	40'	
COARSE SAND	40'	60'	
CHALK	60'	80'	

IF MORE SPACE IS NEEDED, USE BACK

